

LEFLORE
592

MISSISSIPPI DEPARTMENT OF NATURAL RESOURCES
 Bureau of Land and Water Resources
 Southport Mall
 P.O. Box 10631
 Jackson, Mississippi 39209
WATER WELL DRILLERS LOG

CODED

9-21 1984 g+k irrigation Leflore
 date well completed firm name county well located

LANDOWNER:
Eddie Gillam
Otto Bena, Miss
 (mailing address)

description of formations encountered	from	to
<u>CLAY</u>	<u>0</u>	<u>15</u>
<u>FINE SAND</u>	<u>15</u>	<u>33</u>
<u>SAND GRAVEL</u>	<u>33</u>	<u>99</u>

WELL LOCATION:
 sec. 7 T. 19 N R. 2 E
6 1/2 miles NW of Otto Bena
 (distance) (direction) (nearest town)

WELL PURPOSE:
 (home, irrigation, municipal, industrial)

WELL COMPLETION DATA:

- (1) diameter (inches) 16
- (2) total depth (feet) 99
- (3) static water level (feet) 31 ^{below} top of ground
- (4) casing steel 99 59
 (material) (depth)
16 if telescope see back.
 (size)
- (5) screen 40 40
 (length) (depth to top)
16 (size) (material)
- (6) pump 125 1500
 (HP) (yield gpm)
diesel
 (type power)
- (7) electric log NO
 (yes or no)
 (organization running log)
- (8) how well bottom plugged plate

CODED


DEPT. OF NATURAL RESOURCES
 BUREAU OF LAND & WATER RESOURCES

OCT 16 1984
RECEIVED

DRILLERS REMARKS:

If well telescopes please sketch and show depths.

GROUND LEVEL

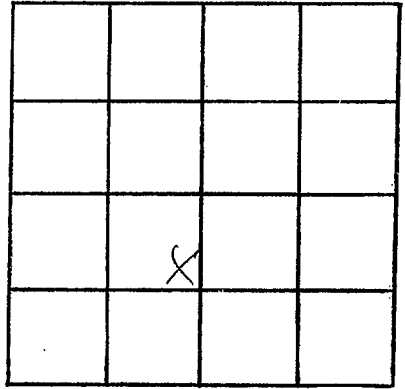

SECTION 7

Please indicate well location X.

ADDITIONAL INFORMATION

If more than one screen,
show locations of each on sketch.