

MISSISSIPPI DEPARTMENT OF NATURAL RESOURCES

Bureau of Land and Water Resources

Southport Mall

P.O. Box 10631

Jackson, Mississippi 39209

WATER WELL DRILLERS LOG

CODED

LEFLORE
J 93

9-20-84
date well completed

1984 J+K Irrigation
firm name

Leflore
county well located

LANDOWNER:
Eddie Bellam
Itha Bera Miss.
(mailing address)

description of formations encountered	from	to
CLAY	0	15
FINE SAND	15	33
SAND gravel	33	98

WELL LOCATION:
sec. 8 T. 19 N R. 2 E
6 miles NW of TUBERVILLE
(distance) (direction) (nearest town)

WELL PURPOSE:
(home, irrigation, municipal, industrial)

- WELL COMPLETION DATA:
- (1) diameter (inches) 16
 - (2) total depth (feet) 98
 - (3) static water level (feet) 29 below above top of ground.
 - (4) casing steel, 59 (material), (depth)
16 (size) if telescope see back.
 - (5) screen 40 (length), (depth to top)
16 (size), steel (material)
 - (6) pump 2.25 (HP), 1500 (yield gpm)
diesel (type power)
 - (7) electric log NO (yes or no)
plate (organization running log)
 - (8) how well bottom plugged plate

CODED


REPT. OF NATURAL RESOURCES
BUREAU OF LAND & WATER RESOURCES

RECEIVED
OCT 16 1984

DRILLERS REMARKS:

If well telescopes please sketch and show depths.

GROUND LEVEL

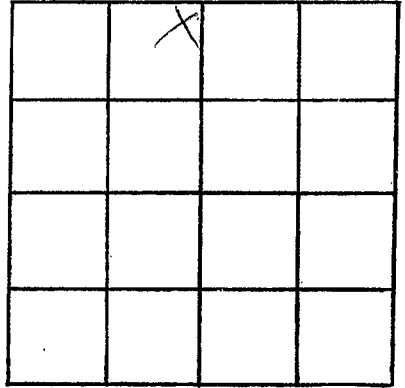

SECTION 8

Please indicate well location X.

ADDITIONAL INFORMATION

If more than one screen, show locations of each on sketch.