

MISSISSIPPI DEPARTMENT OF NATURAL RESOURCES

Bureau of Land and Water Resources

Southport Mall

P.O. Box 10631

Jackson, Mississippi 39209

WATER WELL DRILLERS LOG

CODED

LEFLORE
594

9-19

date well completed

1984 J+K Irrigation

firm name

Leflore

county well located

LANDOWNER:	description of formations encountered	from	to
Eddie Hillam Itta Bena, Miss. (mailing address)			
WELL LOCATION:	FINE SAND	15	33
sec. 8 T. 19 N. R. 2 E. S. W.	SAND Loam	33	99
6 miles NW of Itta Bena (distance) (direction) (nearest town)			
WELL PURPOSE: (home, irrigation, municipal, industrial)			
WELL COMPLETION DATA:			
(1) diameter (inches) 10 1/2			
(2) total depth (feet) 99			
(3) static water level (feet) 31 below top of ground.			
(4) casing steel, 99 (material) (depth)			
16 (size) if telescope see back.			
(5) screen 40 (length) (depth to top)			
16 (size) steel (material)			
(6) pump 125 (HP) 1500 (yield gpm)			
diesel (type power)			
(7) electric log NO (yes or no)			
(organization running log)			
(8) how well bottom plugged plate			
DRILLERS REMARKS:			

CODED


DEPT. OF NATURAL RESOURCES
BUREAU OF LAND & WATER RESOURCES

OCT 16 1984

RECEIVED

If well telescopes please sketch and show depths.

GROUND LEVEL

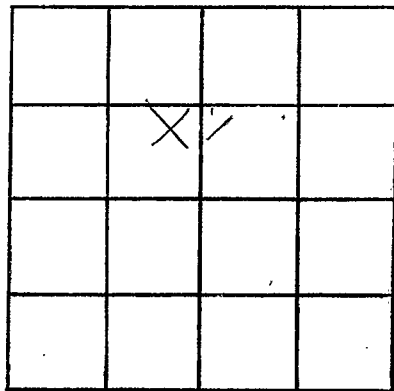

SECTION 8

Please indicate well location X.

ADDITIONAL INFORMATION

If more than one screen,
show locations of each on sketch.