

MISSISSIPPI DEPARTMENT OF NATURAL RESOURCES

Bureau of Land and Water Resources

Southport Mall

P.O. Box 10631

Jackson, Mississippi 39209

WATER WELL DRILLERS LOG

CODED

LEFLORE
598

5-3 1987 J & K Irrigation LeFlore
 date well completed firm name county well located

LANDOWNER: Michael Foudreaux
520 Liveoak Ave
Pascagoula, Miss
 (mailing address)

description of formations encountered	from	to
CLAY	0	26
FINE SAND	26	43
COARSE SAND & GRAVEL	43	117

WELL LOCATION:
 sec 32 T 19 N R 2 E
8 miles S of ITTA BENA
 (distance) (direction) (nearest town)

CODED

WELL PURPOSE: IRRIGATION
 (home, irrigation, municipal, industrial)

WELL COMPLETION DATA:

- (1) diameter (inches) 10"
- (2) total depth (feet) 117
- (3) static water level (feet) 28 below above top of ground.
- (4) casing POC, 87
 (material) (depth)
16" if telescope see back.
 (size)
- (5) screen 40, 87
 (length) (depth to top)
10", POC
 (size) (material)
- (6) pump 20, 1200
 (HP) (yield gpm)
Electric
 (type power)
- (7) electric log NO
 (yes or no)

RECEIVED

JUN 30 1987

(organization running log)


(8) how well bottom plugged CAP

Department of Natural Resources
 Bureau of Land & Water Resources

DRILLERS REMARKS:

If well telescopes please sketch and show depths.

GROUND LEVEL

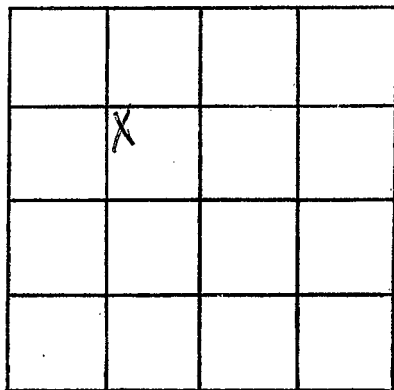

SECTION 32

Please indicate well location X.

ADDITIONAL INFORMATION

If more than one screen,
show locations of each on sketch.