

LEFLORE
J 100
 Gw 7422

MISSISSIPPI DEPARTMENT OF NATURAL RESOURCES
 Bureau of Land and Water Resources
 Southport Mall
 P.O. Box 10631 **CODED**
 Jackson, Mississippi 39209
WATER WELL DRILLERS LOG

5-14 1987 **BUTANE GAS CO. OF GREENWOOD** Leflore
 date well completed firm name county well located

LANDOWNER:
 David Branham
 Itha Bena
 (mailing address)

description of formations encountered	from	to
Clay	0	40
Sand & Gravel	40	93

WELL LOCATION:
 sec. 1 T 19 N R 2 E
 S W
 3 miles N/W of Itha Bena
 (distance) (direction) (nearest town)

WELL PURPOSE: DR
 (home, irrigation, municipal, industrial)

- WELL COMPLETION DATA:**
- (1) diameter (inches) 16"
 - (2) total depth (feet) 93
 - (3) static water level (feet) 40 below above top of ground.
 - (4) casing Steel 53 (material) (depth)
 16" (size) If telescope see back.
 - (5) screen 40 53 (length) (depth to top)
 16" Steel (size) (material)
 - (6) pump 60 2500 (HP) (yield gpm)
 Elec. (type power)
 - (7) electric log NO (yes or no)
 - (organization running log)
 - (8) how well bottom plugged Steel Plate

DRILLERS REMARKS:


CODED

RECEIVED
 JUN 03 1987

Department of Natural Resources
 Bureau of Land & Water Resources

If well telescopes please sketch and show depths.

GROUND LEVEL

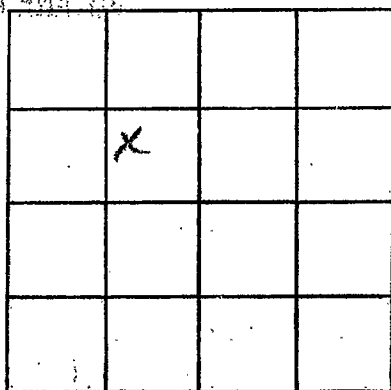

SECTION 1

Please indicate well location X.

ADDITIONAL INFORMATION

If more than one screen,
show locations of each on sketch.