

MISSISSIPPI DEPARTMENT OF NATURAL RESOURCES

Bureau of Land and Water Resources

Southport Mall

P.O. Box 10631

Jackson, Mississippi 39209

WATER WELL DRILLERS LOG

LEFLORE  
J 101  
TEP  
07786-DCR 09-19-87

**CODED**

July 1987 Dyer Well Leflore  
date well completed firm name county well located

LANDOWNER: Practical  
  
(mailing address)

description of formations encountered	from	to
CLAY	0	38
M SAND & Gravel	38	52
Sand & Gravel	52	64
Fine Sand	64	75
Sand & Gravel	75	100

WELL LOCATION:  
sec. 3 T 19 N R 2  
miles 1 1/2 (distance) Atoka River (direction) (nearest town)

WELL PURPOSE:  
(home, irrigation, municipal, industrial)

- WELL COMPLETION DATA:
- (1) diameter (inches) 16"
  - (2) total depth (feet) 100
  - (3) static water level (feet) \_\_\_\_\_ below above top of ground.
  - (4) casing, Steel, \_\_\_\_\_ (material) (depth)  
16" (size) if telescope see back.
  - (5) screen 40' (length) (depth to top)  
16" (size) (material)
  - (6) pump 30 (HP) 1500 (yield gpm)  
Electric (type power)
  - (7) electric log No (yes or no)  
None (organization running log)
  - (8) how well bottom plugged Plate

11 1/2  
35  
30

**RECEIVED**


JUL 31 1987

Department of Natural Resources  
Bureau of Land & Water Resources

DRILLERS REMARKS:

If well telescopes please sketch and show depths.

GROUND LEVEL

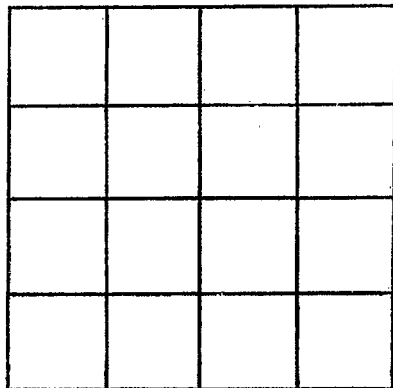

SECTION \_\_\_\_\_

Please indicate well location X.

ADDITIONAL INFORMATION

If more than one screen,  
show locations of each on sketch.