

MISSISSIPPI DEPARTMENT OF NATURAL RESOURCES

Bureau of Land and Water Resources

Southport Mall

P.O. Box 10631

Jackson, Mississippi 39209

WATER WELL DRILLERS LOG

CODED

TEP#

07787-DCP-09-1987

LEFLORE

D-65-87

J 103

8-1-1987

Dyer Well Dr.

Leflore

date well completed

firm name

county well located

LANDOWNER: Prudential Ins.

description of formations encountered

from

to

Memphis, Tenn

(mailing address)

Clay
fine sand
sand + gravel

| | |
|----|----|
| 0 | 30 |
| 30 | 38 |
| 38 | 98 |

WELL LOCATION:

sec. 4 T. 19(N) S. R. 2 E. W. 1
miles (distance) of (direction) of (nearest town)

WELL PURPOSE: Irrigation
(home, irrigation, municipal, industrial)

WELL COMPLETION DATA:

- (1) diameter (inches) 16"
- (2) total depth (feet) 98
- (3) static water level (feet) _____ below/above top of ground.
- (4) casing Steel (material), _____ (depth) 16" (size) If telescope see back.
- (5) screen 40' (length), _____ (depth to top) 16" (size), _____ (material)
- (6) pump _____ (HP), _____ (yield gpm) Electric (type power)
- (7) electric log No (yes or no) None (organization running log)
- (8) how well bottom plugged Plate

CODED

RECEIVED

AUG 05 1987


Department of Natural Resources
Bureau of Land & Water Resources

DRILLERS REMARKS:

TEP.
07787 DCP-09-19-87

If well telescopes please sketch and show depths.

GROUND LEVEL

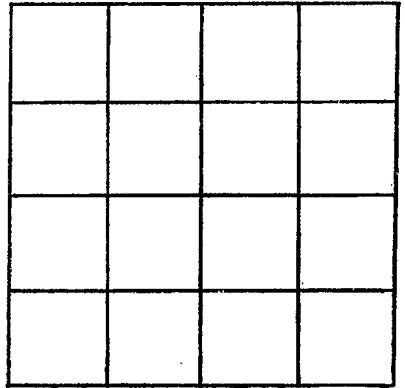

SECTION _____

Please indicate well location X.

ADDITIONAL INFORMATION

If more than one screen,
show locations of each on sketch.