

MISSISSIPPI DEPARTMENT OF NATURAL RESOURCES

Bureau of Land and Water Resources

Southport Mall

P.O. Box 10631

Jackson, Mississippi 39209

WATER WELL DRILLERS LOG

Top
 87308-DCP-02
 LEFLORE
 F 104
 11-4

Caled

1987 Dyer Well

LeFlore

date well completed

firm name

county well located

LANDOWNER: Scott Fish Farm

description of formations encountered

from

to

611 Hwy 82 West
Greenwood Ms 38930
 (mailing address)

Clay	0	28
Fine Sand	28	32
M Sand & Gravel	32	45
Sand & Gravel	45	98

WELL LOCATION:

sec 14 T 19 N R 2 W
2 miles W of Thibodaux
 (distance) (direction) (nearest town)

WELL PURPOSE: Fish Ponds
 (home, irrigation, municipal, industrial)

WELL COMPLETION DATA:

- (1) diameter (inches) 16"
- (2) total depth (feet) 93'
- (3) static water level (feet) _____ below/above top of ground.
- (4) casing Steel (material), _____ (depth),
16" (size) if telescope see back.
- (5) screen 40' (length), _____ (depth to top),
16" (size), _____ (material)
- (6) pump 40 (HP) 2000 (yield gpm)
Electric (type power)
- (7) electric log No (yes or no)
None (organization running log)
- (8) how well bottom plugged Plate

RECEIVED


FEB 01 1988

Department of Natural Resources
 Bureau of Land & Water Resources

DRILLERS REMARKS:

If well telescopes please sketch and show depths.

GROUND LEVEL

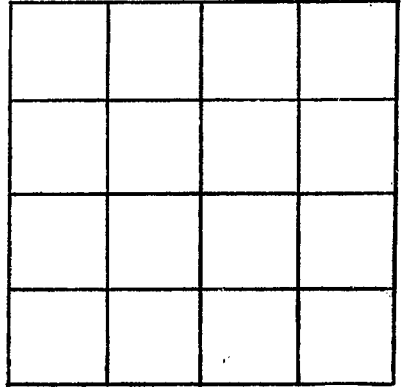

SECTION _____

Please indicate well location X.

ADDITIONAL INFORMATION

If more than one screen,
show locations of each on sketch.