

CODED

MISSISSIPPI DEPARTMENT OF NATURAL RESOURCES
Bureau of Land and Water Resources

P.O. Box 10631

Jackson, Mississippi 39209

WATER WELL DRILLERS LOG

COUNTY WELL LOCATED
LeFlore

WELL NUMBER <u>#108</u>	CODED
DATE WELL COMPLETED <u>4-5-88</u>	

PERMIT NUMBER
NAME OF DRILLING FIRM <u>OK IRRIGATION</u>

NAME & MAILING ADDRESS OF LANDOWNER <u>LeFlore County School</u> <u>P.O. Box 544</u> <u>Greenwood, Miss. 38930</u>			
WELL LOCATION:	SEC <u>16</u>	TOWNSHIP <u>19 N</u>	RANGE <u>2 W</u>
DISTANCE <u>5</u> Miles	DIRECTION <u>W</u>	NEAREST TOWN <u>JTA Barn</u>	
OTHER LANDMARK			
WELL PURPOSE: Home, <u>Irrigation</u> , Municipal, Industrial, Fish Pond, etc. <u>Ⓢ</u>			

PUMP DATA		
PUMP TYPE (Circle One): Submersible, <u>Turbine</u> , Jet, Flowing Well, Other (Describe)		
POWER TYPE (Circle One): Electric, Tractor, <u>Diesel</u> , Gasoline, Butane, Other (Describe)		
Pump Capacity (GPM) <u>3000</u>	No. of Stages <u>1</u>	Setting Depth <u>60</u> FT.
PUMP TEST		
Well yielded <u>3000</u> GPM with a drawdown of <u>23</u> ft. after _____ hours of pumping		

WELL DATA		
Well Depth <u>117</u>	Casing Diameter (In.) <u>16</u>	Casing Length (Ft.) <u>77</u>
Type of Casing <u>Steel</u>	Hole Depth <u>117</u>	Depth to Static Water Level <u>34 Ft.</u>
TYPE OF COMPLETION: (Circle One or More): <u>Gravel Packed</u> , Underreamed, Telescoped, Natural Development, Open Hole, Other (Describe)		
Top of Lap Pipe or Reduction in Casing FEET IF TELESCOPED OR MORE THAN ONE SCREEN: USE BACK PAGE		

LOG DATA	
TYPE OF LOG RUN (Circle One): No Log Run, Electric, Gamma Ray, Density, Sonic, Neutron, Other (Describe)	
Name of Organization Running Log	

SCREEN DATA		
Diameter - Inches <u>16</u>	Length - Feet <u>40</u>	Slot Size - Inches <u>030</u>
Screen Type <u>Steel</u>	Depth to Bottom - Feet <u>117</u>	

GEOLOGIC DATA (Office Use Only)			
Surface Elev.	Geologic Unit	Unit Thickness	Depth to Top
Subs. SWL	Date	Analysis	Aquifer Test

Driller's Remarks


RECEIVED

DESCRIPTION OF FORMATIONS ENCOUNTERED	FROM	TO	FORMATIONS (Continued)	FROM	TO
<u>Clay</u>	<u>0</u>	<u>18</u>	SEP 14 1988 Department of Natural Resources Bureau of Land & Water Resources		
<u>Fine Sand</u>	<u>18</u>	<u>43</u>			
<u>Coarse Sand & Gravel</u>	<u>43</u>	<u>117</u>			

IF MORE SPACE IS NEEDED, USE BACK

If well telescopes please sketch and show depths.

GROUND LEVEL

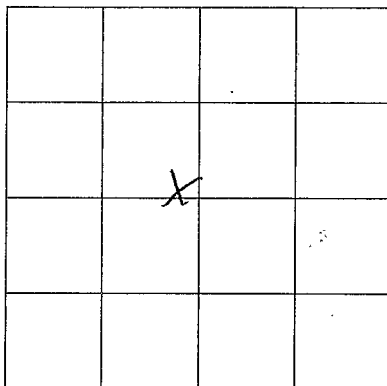

SECTION 16

Please indicate well location X.

ADDITIONAL INFORMATION

If more than one screen,
show location of each on sketch.