

MISSISSIPPI DEPARTMENT OF ENVIRONMENTAL QUALITY
Bureau of Land and Water Resources

P. O. Box 10631
Jackson, MS 39289-0631
WATER WELL DRILLERS LOG

COUNTY WELL LOCATED <u>LeFlore</u>	
WELL NUMBER <u>Site-6 Well-1</u>	CODED <input checked="" type="checkbox"/>
DATE WELL COMPLETED <u>4/30/94</u>	

PERMIT NUMBER
NAME OF DRILLING FIRM <u>Layne-Central</u>

NAME & MAILING ADDRESS OF LANDOWNER <u>Steve Scott</u> <u>Route 1, Box 172</u>	
WELL LOCATION: SEC <u>9</u> TOWNSHIP <u>T19</u> RANGE <u>R2</u>	
DISTANCE _____ Miles _____ of _____	
OTHER LANDMARK	
WELL PURPOSE: Home, <u>Irrigation</u> Municipal, Industrial, Fish Pond, etc.	

PUMP DATA		
PUMP TYPE (Circle One): Submersible, Turbine, Jet, Flowing Well, Other (Describe) _____		
POWER TYPE (Circle One): Electric, Tractor, Diesel, Gasoline, Butane, Other (Describe) _____ H/P _____		
Pump Capacity (GPM)	No. of Stages	Setting Depth _____ FT.
PUMP TEST		
Well yielded _____ GPM with a drawdown of _____ ft. after _____ hours of pumping		

WELL DATA		
Well Depth <u>105'</u>	Casing Diameter (In.) <u>6" x 4"</u>	Casing Length (Ft.) <u>95'</u>
Type of Casing <u>PVC</u>	Hole Depth <u>107'</u>	Depth to Static Water Level
TYPE OF COMPLETION: (Circle One or More): <u>Gravel Packed</u> , Underreamed, Telescoped, Natural Development, Open Hole, Other		
Top of Lap Pipe or Reduction in Casing <u>6 FEET</u> IF TELESCOPED OR MORE THAN ONE SCREEN: USE BACK PAGE		

LOG DATA	
TYPE OF LOG RUN (Circle One): <u>Electric</u> , Gamma Ray, Density, Sonic, Neutron, Other (Describe) <u>J 006</u>	
Name of Organization Running Log <u>State</u>	


SCREEN DATA		
Diameter - Inches <u>4"</u>	Length - Feet <u>10'</u>	Slot Size - Inches <u>.010"</u>
Screen Type <u>PVC</u>	Depth to Bottom - Feet <u>100'</u>	

GEOLOGIC DATA (Office Use Only)			
Surface Elev.	Geologic Unit	Unit Thickness	Depth to Top
Subs. SWL	Date	Analysis	Aquifer Test
Driller's Remarks			

DESCRIPTION OF FORMATIONS ENCOUNTERED	FROM	TO
<u>Clay</u>	<u>0</u>	<u>35</u>
<u>Sand</u>	<u>35</u>	<u>50</u>
<u>Coarse Sand</u>	<u>50</u>	<u>64</u>
<u>Cor. Sand & Pee Gravel</u>	<u>64</u>	<u>96</u>
<u>Cor. Sand & Gravel</u>	<u>96</u>	<u>101</u>
<u>Clay</u>	<u>101</u>	<u>107</u>

FORMATIONS (Continued)	FROM	TO
RECEIVED		
JUL 25 1994		
Dept. of Environmental Quality Office of Land & Water Resources		
IF MORE SPACE IS NEEDED, USE BACK		

If well telescopes please sketch and show depths.

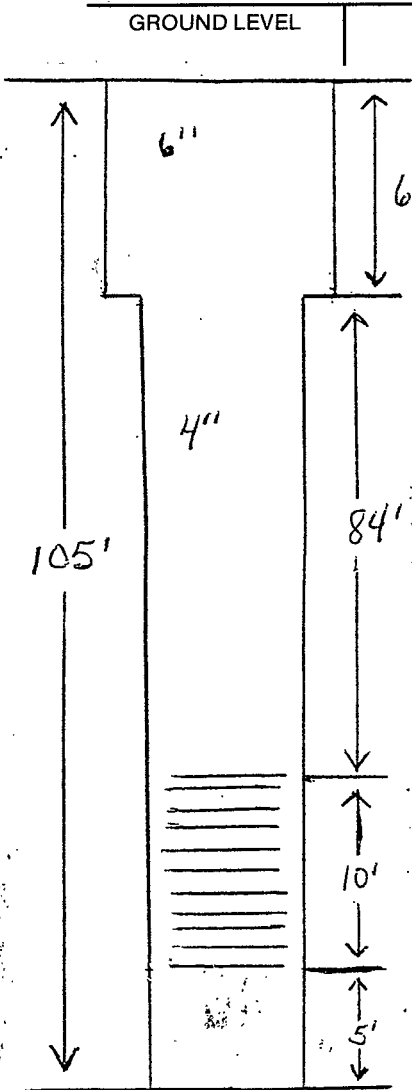

SECTION _____

Please indicate well location X.

ADDITIONAL INFORMATION

If more than one screen, show location of each on sketch.