

MISSISSIPPI DEPARTMENT OF ENVIRONMENTAL QUALITY

Office of Land and Water Resources

P. O. Box 10631  
Jackson, MS 39289-0631  
WATER WELL DRILLERS LOG

COUNTY WELL LOCATED  
**LEFFLORE**

WELL NUMBER **1** CODED

**J-131**

DATE WELL COMPLETED  
**2/14/02**

PERMIT NUMBER

NAME OF DRILLING FIRM  
**AL Ford Irr. Co.**

NAME & MAILING ADDRESS OF LANDOWNER  
**Barnham Ag Service**  
**Barnham**

**ITTA Beau Miss**

WELL LOCATION: SEC **2** TOWNSHIP **T19** RANGE **R2**

DISTANCE **2 1/2** Miles DIRECTION **SE** NEAREST TOWN **ITTA BEAU**

OTHER LANDMARK

WELL PURPOSE: Home, Irrigation, Municipal, Industrial, Fish Pond, etc.

PUMP DATA

PUMP TYPE (Circle One): **Turbine** Jet Flowing Well, Other (Describe)

POWER TYPE (Circle One): Electric, Tractor, **Diesel** Gasoline, Butane, Other (Describe) H/P **60**

Pump Capacity (GPM) **2500** No. of Stages **2** Setting Depth **60** FT.

PUMP TEST

Well yielded \_\_\_\_\_ GPM with a drawdown of \_\_\_\_\_ ft. after \_\_\_\_\_ hours of pumping

WELL DATA

Well Depth **125'** Casing Diameter (In.) **16** Casing Length (Ft.) **85**

Type of Casing **PVC** Hole Depth **125** Depth to Static Water Level

TYPE OF COMPLETION: (Circle One or More): **Gravel Packed** Underreamed, Telescoped, Natural Development, Open Hole, Other

WELL GROUTED TO A DEPTH OF \_\_\_\_\_ FEET Type Grout (circle one): Cement, Bentonite, or Mix

SCREEN DATA

Diameter - Inches **16** Length - Feet **40** Slot Size - Inches **72**

Screen Type **PVC** Depth to Bottom - Feet **125**

LOG DATA

TYPE OF LOG RUN (Circle One): **No Log Run** Electric, Gamma Ray, Density, Sonic, Neutron, Other (Describe)

Name of Organization Running Log

GEOLOGIC DATA (Office Use Only)

Surface Elev.	Geologic Unit	Unit Thickness	Depth to Top
Subs. SWL	Date	Analysis	Aquifer Test


Driller's Remarks

DESCRIPTION OF FORMATIONS ENCOUNTERED	FROM	TO	FORMATIONS (Continued)	FROM	TO
<b>CLAY</b>	<b>0</b>	<b>18</b>			
<b>FINE SAND</b>	<b>18</b>	<b>27</b>			
<b>SAND GRAVEL</b>	<b>27</b>	<b>125</b>			

RECEIVED  
FEB 18 2003  
BY: OLWR

If well telescopes please sketch and show depths.

GROUND LEVEL

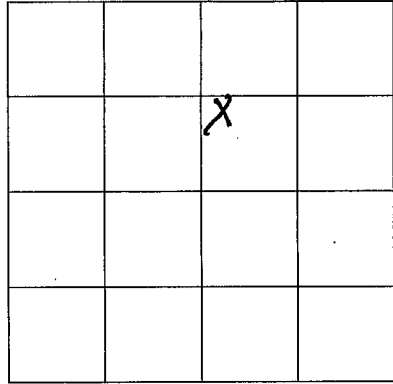

SECTION 2

Please indicate well location X.

ADDITIONAL INFORMATION

If more than one screen,  
show location of each on sketch.