

State Well Report

Part 1

Mississippi Department of Environmental Quality
Office of Land and Water Resources
P.O. Box 10631
Jackson, MS 39289-0631
(601)961-5210
(601)354-6938 (fax)

For Office Use Only:

Aquifer: _____
Well #: J-145
L. S. Elevation: _____
E-log #: _____

County: Leflore
Permit #: GW 40106
Irrigation Equipment
Driller: _____
Date drilling completed: 4-16-05

State Law requires that this report be prepared by the driller in detail and filed with the Department within 30 days of completion of drilling of the well.

Well Owner Information	Well Location
Owner Name: <u>Prestidge Farms</u>	Latitude: _____ " Longitude: _____ "
Mailing Address: <u>37301 County Road 523</u>	Method of Lat/Long (circle one): <u>Conventional Survey</u>
<u>Schlater, MS 38952</u>	USGS quad, Hand-held GPS, Survey-grade GPS
City State Zip Code	<u>SE NW 1/4 SE 1/4 Sec 11 2 Twn 19N Rng 2W</u>
Telephone No. (<u>662</u>)- <u>254-6408</u>	Distance Direction Nearest Town <u>4 Miles NW of Itta Bena</u>

Well Data

Purpose of Well (circle one) Home Industrial Public Supply Irrigation Fish Culture Other: _____
Date well drilling started: 4-16-05 Date well drilling completed: 4-16-05
If flowing, method of flow regulation: Valve _____ Other (describe) _____
Static Water Level: 30' feet above or below (circle one) land surface Date measured: 4-16-05
Method of Measurement (circle one) steel tape electric tape air line other: _____
Hole depth: 126' Well depth: 126' Well grouted to a depth of 10 feet
Type of grout (circle one): Cement Bentonite Mix
Casing length: 86 feet Casing diameter: 16 inches Type of casing: Sch. 40 PVC
Screen length: 40 feet Screen diameter: 16 inches Type of screen: Sch. 40 PVC
Screen slot size: .050 inches Setting depth: From 87 feet to 126 feet
Type of completion (circle all applicable): Gravel packed Underreamed Telescoped Open hole Natural Development
Other (describe): _____

Top of lap pipe or reduction in casing: _____ feet. If telescoped or more than one screen, describe on back of page

Logs run (circle all applicable): No log run Electric Gamma Ray Density Sonic Neutron Other: _____

Name of organization running log(s): _____

I certify that the well was drilled, constructed, and completed in accordance with all applicable requirements of the Mississippi Department of Environmental Quality and/or the Mississippi Department of Health regulations and state laws.

Irrigation Equipment Inc.
Patrick M. Chism 0695

Patrick M Chism

Print Name of Water Well Contractor and License No.

Signature of Water Well Contractor

RECEIVED
APR 29 2005
BY: OLWR

If well telescopes please sketch below and show depths.

J-145


Ground Level

--	--

Description of Formations Encountered	From	To
Clay	0	38
Fine Sand	39	45
Fine Sand/gravel	46	55
Med. Sand/gravel	56	126

If more than one screen, show location of each on sketch

Sketch the property layout and include the following: 1) the well location; 2) any permanent structures on the property that may aid in locating the well; 3) any roads, power lines, or other items that may aid in locating the property and the well; 4) indicate direction.

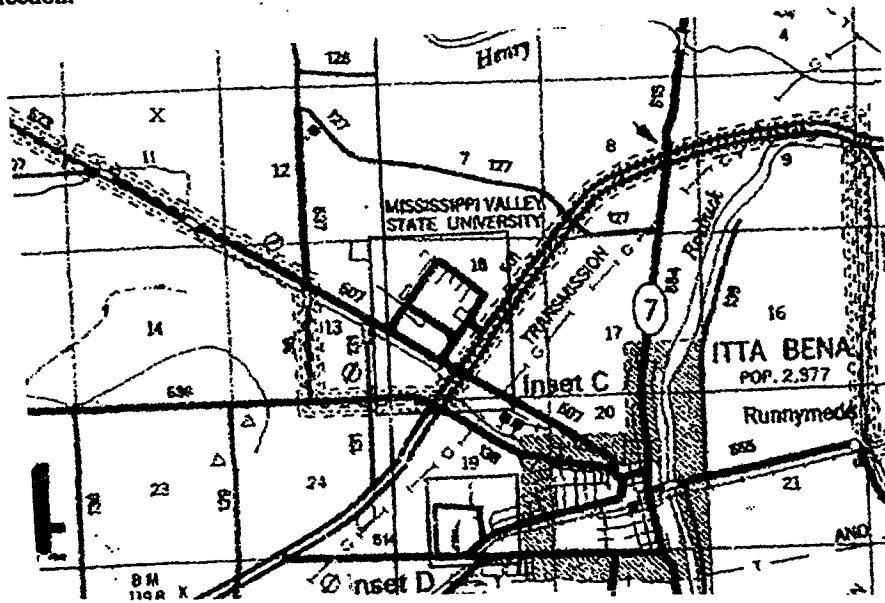

Landowner Name: _____

Patrick M. Chan

Signature of Water Well Contractor

STATE WELL REPORT

Part 2

Pump Installer's Completion Report
 Mississippi Department of Environmental Quality
 Office of Land and Water Resources
 P.O. Box 10631
 Jackson, MS 39289-0631
 (601)961-5210
 (601)354-6938 (fax)

County: Leflore
 Permit #: OW 40106
 Irrigation Equipment
 Driller: _____
 Date completed: 4-16-05

For Office Use Only:

Aquifer: _____
 Well #: J-145
 Elevation: _____

This report should be prepared by the pump installer in detail and filed with the Department within 30 days of the installation of pump.

Well Owner Information	Well Location
Owner Name: <u>Prestidge Farms</u>	Latitude: _____ Longitude: _____
Mailing Address: <u>37301 County Road 523</u>	Method of Lat/Long (circle one): <input type="checkbox"/> Conventional Survey,
<u>Schlater, MS 38952</u>	USGS quad, Hand-held GPS, Survey-grade GPS
City State Zip Code	NW $\frac{1}{4}$ NE $\frac{1}{4}$ Sec <u>11</u> Twn <u>19N</u> Rng <u>2W</u>
Telephone No. (____) _____	Distance Direction Nearest Town
	<u>4</u> Miles <u>NW</u> of <u>Itta Bena</u>

RECEIVED

APR 29 2005

BY: OLWR

Pump Type Circle one	Power Type Circle one
Air Lift Jet Submersible	Diesel Engine Gasoline Engine Natural Gas
Bucket Piston <u>Turbine</u>	<u>Electric Motor</u> Hand Tractor PTO
Centrifugal Rotary Flowing Well	Windmill Other (specify): _____
Other (specify): _____	Horse Power Rating of Motor: <u>40</u>
Date Pump Installed: <u>4-16-05</u>	Setting Depth: <u>60</u> feet
Rated Pump Capacity: <u>2000</u> Gallons Per Minute	Number of Stages: <u>2</u>

Pump Test Data	Method of Measuring Water Level Circle one
Date Well Tested: _____	Air Line Electric Measuring Line Steel Tape
Static Water Level (A): _____ Feet Below Land Surface	Other (specify): _____
Pumping Water Level (B): _____ Feet Below Land Surface	For flowing well, measured shut in head: _____ feet
Drawdown [(B) - (A)]: _____ Feet Below Land Surface	Well yielded _____ GPM with a drawdown of
Test Pumping Rate: _____ Gallons Per Minute	_____ feet after _____ hours of pumping
Duration of Pump Test (minimum 4 hours): _____ hours	

I HEREBY CERTIFY that the above statements are true to the best of my knowledge.

Patrick M. Chism 0695 Patrick M Chism
 Print Name of Pump Installer and License No. (if applicable) Signature of Pump Installer

State Well Report

Part 1

Mississippi Department of Environmental Quality
 Office of Land and Water Resources
 P.O. Box 10631
 Jackson, MS 39289-0631
 (601)961-5210
 (601)354-6938 (fax)

For Office Use Only:

Aquifer: _____

Well #: J 145

L. S. Elevation: _____

E-log #: _____

County: LeflorePermit #: 441 40106Driller: Irrigation EquipmentDate drilling completed: 4-16-05

State Law requires that this report be prepared by the driller in detail and filed with the Department within 30 days of completion of drilling of the well.

Well Owner Information

Owner Name: Prestidge FarmsMailing Address: 37301 County Road 523

Schlater, MS 38952
 City State Zip Code

Telephone No.: (662) 254-6408

Well Location

Latitude: _____ Longitude: _____

Method of Lat/Long (circle one): Conventional Survey

USGS quad, Hand-held GPS, Survey-grade GPS

NW 1/4 NE 1/4 Sec 7T Twn 19N Rng 2W

SE SE 2
 Distance Direction Nearest Town
4 Miles NW of Itta Bena

Well Data

Purpose of Well (circle one) Home Industrial Public Supply Irrigation Fish Culture Other: _____Date well drilling started: 4-16-05 Date well drilling completed: 4-16-05

If flowing, method of flow regulation: Valve _____ Other (describe) _____

Static Water Level: 30' feet above or below (circle one) land surface Date measured: 4-16-05Method of Measurement (circle one) steel tape electric tape air line other: _____Hole depth: 126' Well depth: 126' Well grouted to a depth of 10 feetType of grout (circle one): Cement Bentonite MixCasing length: 86 feet Casing diameter: 16 inches Type of casing: Sch. 40 PVCScreen length: 40 feet Screen diameter: 16 inches Type of screen: Sch. 40 PVCScreen slot size: .050 inches Setting depth: From 87 feet to 126 feetType of completion (circle all applicable): Gravel packed Underreamed Telescoped Open hole Natural Development

Other (describe): _____

Top of lap pipe or reduction in casing: _____ feet. If telescoped or more than one screen, describe on back of page

Logs run (circle all applicable): No log run Electric Gamma Ray Density Sonic Neutron Other: _____

Name of organization running log(s): _____

I certify that the well was drilled, constructed, and completed in accordance with all applicable requirements of the Mississippi Department of Environmental Quality and/or the Mississippi Department of Health regulations and state laws.

Irrigation Equipment Inc.
 Patrick M. Chism 0695

Patrick M Chism

Print Name of Water Well Contractor and License No.

Signature of Water Well Contractor

RECEIVED

APR 29 2005

MD JOINT WATER MANAGEMENT DISTRICT

40106