County: Leflore			
Permit #:	6W	401	80
Irrigation Equipment			
Date drilling	completed:	4-2	9-05

State Well Report

Part 1

Mississippi Department of Environmental Quality
Office of Land and Water Resources
P.O. Box 10631
Jackson, MS 39289-0631
(601)961-5210
(601)354-6938 (fax)

For Office Use Only:	
Aquifer:	
Well #: <u>J- 148</u>	
L. S. Elevation:	
E-log #:	

State Law requires that this report be prepared by the driller in detail and filed with the Department within 30 days of completion of drilling of the well.

30 days of completion of drilling of the well.			
Well Owner Information	Well Location		
Owner Name Prestidge Farms	Latitude:, 31 , 37 , 9 Longitude:, 22 , 33 , 9		
Mailing Address: 37301 County Road 523	Method of Lat/Long (circle one): Conventional Survey,		
	USGS quad, Hand-held GPS, Survey-grade GPS		
	USGS quad, Hand-held GPS, Survey-grade GPS SW 1/4 NZ 1/4 Sec 11 Twn 19N Rng 2W		
Schlater, MS 38952	Win win king win		
City State Zip Code	Distance Direction Nearest Town Miles NW of Itta Bena		
Telephone No. (662)-254-6408	Miles Miles Miles		
Well I	Data		
Purpose of Well (circle one) Home Industrial Public Supply	rrigation Fish Culture Other:		
Date well drilling started: 4-29-05 Date w	well drilling completed: 4-29-05		
If flowing, method of flow regulation: Valve Other (de	escribe)		
Static Water Level: 42 feet above of below (circle one) le	and surface Date measured: $4-30-05$		
Method of Measurement (circle one) steel tape electric tape	air line other:		
Hole depth: 117! Well depth: 117!	Well grouted to a depth of 10 feet		
Type of grout (circle one): Cement Bentonite Mix			
Casing length: 77 feet Casing diameter: 16	inches Type of casing: PVC SCh, 40		
Screen length: 40 feet Screen diameter: 16	_inches Type of screen:PVC Sch.40		
Screen slot size:	78 <u>feet to 117</u> feet		
Type of completion (circle all applicable): Gravel packed Unders	reamed Telescoped Open hole Natural Development		
Other (describe):			
Top of lap pipe or reduction in casing:feet. If telescoped or more than one screen, describe on back of page			
Logs run (circle all applicable): No log run Electric Gamma Ray Density Sonic Neutron Other:			
Name of organization running log(s):			
I certify that the well was drilled, constructed, and completed in accordance with all applicable requirements of the Mississippi			
Department of Environmental Quality and/or the Mississippi Department of Health regulations and state laws.			
Irrigation Equipment Inc.			
Patrick M. Chism 0695	Vatura M Chron		
Print Name of Water Well Contractor and License No.	Signature of Water Well Contractor		

RECEIVED

MAY 19 2005


BY: OLWR

Ground Level

J- 148

Description of Formations Encountered	From	To_
Clay	0	35
Fine Sand	36	45
Med Sand	46	55
Med. Sand Coarse Sand/gravel	56	95
Rock	96	117
ACCK		
	<u> </u>	$oxed{oxed}$
		$ldsymbol{\perp}$
	1	
		<u> </u>

If more than one screen, show location of each on sketch

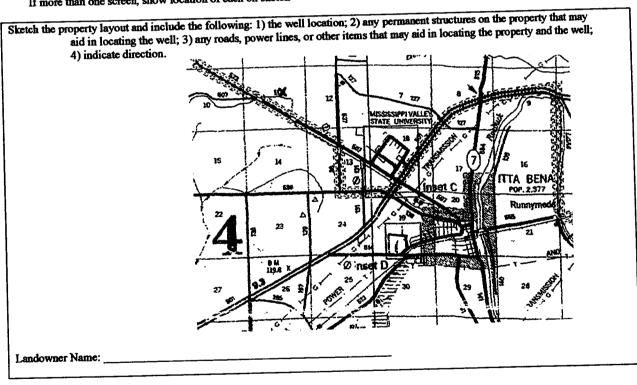

Family M China Signature of Water Well Contractor

STATE WELL REPORT

Part 2

County: Leflore

Permit#: 6 W 40180

Irrigation Equipment
Driller:

Date completed: 4-30-05

Pump Installer's Completion Report
Mississippi Department of Environmental Quality
Office of Land and Water Resources
P.O. Box 10631
Jackson, MS 39289-0631
(601)961-5210
(601)354-6938 (fax)

For Office Use Only:			
Aquifer:			
Well #:	J.	148	_
Elevation	ı:		_

This report should be prepared by the pump installer in detail and filed with the Department within 30 days of the

installation of pump.	337. M.T	
Well Owner Information	Well Location	
Owner Name: Prestidge Farms	Latitude: Longitude:	
Mailing Address: 37301 County Road 523	Method of Lat/Long (circle one): Conventional Survey,	
	USGS quad, Hand-held GPS, Survey-grade GPS	
Cableton MC 20052	SW 4NE 4 Sec 11 Twn 19N Rng 2W	
Schlater, MS 38952 City State Zip Code		
•	Distance Direction Nearest Town	
662-254-6408 Telephone No. ()	3NWofItta Bena	
Total Production (Control Production Control Produc		
Pum p Type Circle one	Power Type Circle one	
Air Lift Jet Submersible	Diesel Engine Gasoline Engine Natural Gas	
Bucket Piston Turbine	Electric Motor Hand Tractor PTO	
Centrifugal Rotary Flowing Well	Windmill Other (specify):	
Other (specify):	Horse Power Rating of Motor: 60	
Date Pump Installed: $4-30-05$	Setting Depth: 60 feet	
Rated Pump Capacity: 2000 Gallons Per Minute	Number of Stages: 2	
Pump Test Data	Method of Measuring Water Level Circle one	
Date Well Tested:	Air Line Electric Measuring Line Steel Tape	
Static Water Level (A):Feet Below Land Surface		
Pumping Water Level (B):Feet Below Land Surface	Other (specify):	
Drawdown [(B) - (A)]:Feet Below Land Surface	For flowing well, measured shut in head:feet	
Test Pumping Rate:Gallons Per Minute	Well yieldedGPM with a drawdown of	
Duration of Pump Test (minimum 4 hours): hours feet after hours of pumping		
I HEREBY CERTIFY that the above statements are true to the best of my kmawledge. Patrick M. Chism 0695 Patrick M. Chism 0695		
Print Name of Pump Installer and License No. (if applicable)	Signature of Pump Installer	

RECEIVED

MAY 1 9 2005

BY: OLWP

County: Leflore	
- Maria	LANSO
Irrigation	Equipment
Date drilling completed:	4-29-05

State Well Report

Part 1
Mississippi Department of Environmental Quality
Office of Land and Water Resources
P.O. Box 10631
Jackson, MS 39289-0631
(601)961-5210
(601)354-6938 (fax)

For Office Use Only:		
Aquifer:_	1/0	
Well #: _	J 148	
L. S. Elevation:		
E-log#:_		

State Law requires that this report be prepared by the driller in detail and filed with the Department within 30 days of completion of drilling of the well.

30 days of completion of drilling of the well.		
Well Owner Information	Well Location	
Owner Name Prestidge Farms	Latitude: 33 31 37 9 Longitude: 90 22, 33 9	
Mailing Address: 37301 County Road 523	Method of Lat/Long (circle one): Conventional Survey,	
	USGS quad, Hand-held GPS, Survey-grade GPS	
Schlater, MS 38952	SW 1/2 NE 1/2 Sec 11 Twn 19N Rng 2W	
City State Zip Code	Miles NW Nearest Town	
Telephone No. (662)-254-6408	- RECEIVED	
Well I	Data	
Well I	1 1 2 2 2 2 2 2 2 2 2 2 2 2 2 2 2 2 2 2	
Purpose of Well (circle one) Home Industrial Public Supply	Grigation Fish Culture Other: MAY 18 2005	
Date well drilling started: 4-29-05 Date v	vell drilling completed: 4-29 JOHNT WATER	
If flowing, method of flow regulation: Valve Other (d	escribe) MANAGEMENT DISTING	
Static Water Level: 42' feet above of below (circle one) l	and surface Date measured: 4-30-05	
Method of Measurement (circle one) steel tape electric tape	air line other:	
Hole depth: 117' Well depth: 117'	Well grouted to a depth of 10 feet	
Type of grout (circle one): Cement Bentonite Mix		
Casing length: 77 feet Casing diameter: 16	inches Type of casing: PVC SCh. 40	
Screen length: 40 feet Screen diameter: 16	inches Type of screen: PVC Sch. 40	
Screen slot size: . 050 inches Setting depth: From _	78feet_to117feet	
Type of completion (circle all applicable): Cravel packed Under	reamed Telescoped Open hole Natural Development	
Other (describe):		
Top of lap pipe or reduction in casing: feet. If tel	escoped or more than one screen, describe on back of page	
Logs run (circle all applicable): No log run Electric Gamma Ray Density Sonic Neutron Other:		
Name of organization running log(s):		
I certify that the well was drilled, constructed, and completed in accordance with all applicable requirements of the Mississippi		
Department of Environmental Quality and/or the Mississippi Department of Health regulations and state laws.		
Patrick M. Chism 0695 Patrick M. Chism 0695		
Print Name of Water Well Contractor and License No.	Signature of Water Well Contractor	

