

State Well Report

Part 1

Mississippi Department of Environmental Quality
Office of Land and Water Resources
P.O. Box 10631
Jackson, MS 39289-0631
(601)961-5210
(601)354-6938 (fax)

County: Leflore
Permit #: MS66040300
Irrigation Equipment
Driller: _____
Date drilling completed: 5-20-05

For Office Use Only:
Aquifer: _____
Well #: J-149
L. S. Elevation: _____
E-log #: _____

State Law requires that this report be prepared by the driller in detail and filed with the Department within 30 days of completion of drilling of the well.

Well Owner Information	Well Location
Owner Name: <u>Scotland Fisheries</u>	Latitude: <u>33 31 .50</u> Longitude: <u>90 24 18.3</u>
Mailing Address: <u>22550 County Road 507</u>	Method of Lat/Long (circle one): <u>Conventional Survey</u>
	USGS quad, Hand-held GPS, Survey-grade GPS
	<u>NW</u> NE 1/4 NE 1/4 Sec <u>9</u> Twn <u>19N</u> Rng <u>2W</u>
<u>Itta Bena, MS 38941</u> City State Zip Code	Distance Direction Nearest Town <u>5</u> Miles <u>NW</u> of <u>Itta Bena</u>
Telephone No. (<u>662</u>) <u>254-9106</u>	

Well Data

Purpose of Well (circle one) Home Industrial Public Supply Irrigation Fish Culture Other Pond 84 Replacement

Date well drilling started: 5-20-05 Date well drilling completed: 5-20-05

If flowing, method of flow regulation: Valve _____ Other (describe) _____

Static Water Level: 51' feet above of below (circle one) land surface Date measured: 5-23-05

Method of Measurement (circle one) steel tape electric tape air line other: _____

Hole depth: 107 Well depth: 107 Well grouted to a depth of 10 feet

Type of grout (circle one): Cement Bentonite Mix

Casing length: 67 feet Casing diameter: 16 inches Type of casing: PVC Sch. 40

Screen length: 40 feet Screen diameter: 16 inches Type of screen: PVC Sch. 40

Screen slot size: .050 inches Setting depth: From 68 feet to 107 feet

Type of completion (circle all applicable): Gravel packed Underreamed Telescoped Open hole Natural Development
Other (describe): _____

Top of lap pipe or reduction in casing: _____ feet. If telescoped or more than one screen, describe on back of page

Logs run (circle all applicable): No log run Electric Gamma Ray Density Sonic Neutron Other: _____

Name of organization running log(s): _____

I certify that the well was drilled, constructed, and completed in accordance with all applicable requirements of the Mississippi Department of Environmental Quality and/or the Mississippi Department of Health regulations and state laws.

Irrigation Equipment Inc.
Patrick M. Chism 0695

Patrick M Chism
Signature of Water Well Contractor

Print Name of Water Well Contractor and License No.

RECEIVED

JUN 15 2005

BY: OLWR

STATE WELL REPORT

Part 2

Pump Installer's Completion Report
 Mississippi Department of Environmental Quality
 Office of Land and Water Resources
 P.O. Box 10631
 Jackson, MS 39289-0631
 (601)961-5210
 (601)354-6938 (fax)

County: Leflore
 Permit #: MSGW 40300
 Irrigation Equipment
 Driller: _____
 Date completed: 5-23-05

For Office Use Only:

Aquifer: _____
 Well #: J-149
 Elevation: _____

This report should be prepared by the pump installer in detail and filed with the Department within 30 days of the installation of pump.

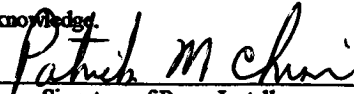
Well Owner Information	Well Location
Owner Name: <u>Scotland Fisheries</u> Mailing Address: <u>22550 County Road 507</u> _____ <u>Itta Bena, MS 38941</u> City State Zip Code Telephone No. (<u>662-254-9106</u>)	Latitude: _____ Longitude: _____ Method of Lat/Long (circle one): Conventional Survey, USGS quad, Hand-held GPS, Survey-grade GPS _____ 1/4 _____ 1/4 Sec <u>9</u> Twn <u>19N</u> Rng <u>2W</u> Distance Direction Nearest Town <u>5</u> Miles <u>NW</u> of <u>Itta Bena</u>

Pump Type Circle one	Power Type Circle one
Air Lift Jet <input type="checkbox"/> Submersible <input checked="" type="checkbox"/> Bucket Piston <input type="checkbox"/> <u>Turbine</u> Centrifugal Rotary <input type="checkbox"/> Flowing Well <input type="checkbox"/> Other (specify): _____ Date Pump Installed: <u>5-23-05</u> Rated Pump Capacity: <u>1500</u> Gallons Per Minute	Diesel Engine <input type="checkbox"/> Gasoline Engine <input type="checkbox"/> Natural Gas <input type="checkbox"/> <u>Electric Motor</u> <input checked="" type="checkbox"/> Hand <input type="checkbox"/> Tractor PTO <input type="checkbox"/> Windmill <input type="checkbox"/> Other (specify): _____ Horse Power Rating of Motor: <u>30</u> Setting Depth: <u>80</u> feet Number of Stages: <u>2</u>

Pump Test Data	Method of Measuring Water Level Circle one
Date Well Tested: _____ Static Water Level (A): _____ Feet Below Land Surface Pumping Water Level (B): _____ Feet Below Land Surface Drawdown [(B) - (A)]: _____ Feet Below Land Surface Test Pumping Rate: _____ Gallons Per Minute Duration of Pump Test (minimum 4 hours): _____ hours	Air Line <input type="checkbox"/> Electric Measuring Line <input type="checkbox"/> Steel Tape <input type="checkbox"/> Other (specify): _____ For flowing well, measured shut in head: _____ feet Well yielded _____ GPM with a drawdown of _____ feet after _____ hours of pumping

I HEREBY CERTIFY that the above statements are true to the best of my knowledge.

Patrick M. Chism 0695
 Print Name of Pump Installer and License No. (if applicable)


 Signature of Pump Installer

RECEIVED
 JUN 15 2005
 BY: OLWR

State Well Report Part 1

Mississippi Department of Environmental Quality
Office of Land and Water Resources
P.O. Box 10631
Jackson, MS 39289-0631
(601)961-5210
(601)354-6938 (fax)

Leflore

Irrigation Equipment

Date drilling completed: 5-20-05

For Office Use Only:

Aquifer: _____
Well #: J-149
L. S. Elevation: _____
E-log #: _____

State Law requires that this report be prepared by the driller in detail and filed with the Department within 30 days of completion of drilling of the well.

Well Owner Information	Well Location
Owner Name: <u>Scotland Fisheries</u>	Latitude: <u>33.3150.1</u> Longitude: <u>90.2418.3</u>
Mailing Address: <u>22550 County Road 507</u>	Method of Lat/Long (circle one): <u>Conventional Survey</u> , <u>USGS quad, Hand-held GPS, Survey-grade GPS</u>
<u>Itta Bena, MS 38941</u>	<u>NE 1/4 NE 1/4 Sec 9 Twn 19N Rng 2W</u>
City State Zip Code	Distance Direction Nearest Town
Telephone No. <u>662-254-9106</u>	<u>5 Miles NW of Itta Bena</u>
Well Data	
Purpose of Well (circle one) Home Industrial Public Supply Irrigation <u>Fish Culture</u> <u>Other</u> <u>Pond 84 Replacement</u>	
Date well drilling started: <u>5-20-05</u> Date well drilling completed: <u>5-20-05</u>	
If flowing, method of flow regulation: Valve _____ Other (describe) _____	
Static Water Level: <u>51'</u> feet above or below (circle one) land surface Date measured: <u>5-23-05</u>	
Method of Measurement (circle one) <u>steel tape</u> electric tape air line other: _____	
Hole depth: <u>107</u> Well depth: <u>107</u> Well grouted to a depth of <u>10</u> feet	
Type of grout (circle one): Cement <u>Bentonite</u> Mix	
Casing length: <u>67</u> feet Casing diameter: <u>16</u> inches Type of casing: <u>PVC Sch. 40</u>	
Screen length: <u>40</u> feet Screen diameter: <u>16</u> inches Type of screen: <u>PVC Sch. 40</u>	
Screen slot size: <u>.050</u> inches Setting depth: From <u>68</u> feet to <u>107</u> feet	
Type of completion (circle all applicable): <u>Gravel packed</u> Underreamed Telescoped Open hole Natural Development Other (describe): _____	
Top of lap pipe or reduction in casing: _____ feet. If telescoped or more than one screen, describe on back of page	
Logs run (circle all applicable): <u>No log run</u> Electric Gamma Ray Density Sonic Neutron Other: _____	
Name of organization running log(s): _____	
I certify that the well was drilled, constructed, and completed in accordance with all applicable requirements of the Mississippi Department of Environmental Quality and/or the Mississippi Department of Health regulations and state laws.	
<u>Irrigation Equipment Inc.</u> <u>Patrick M. Chism 0695</u>	<u>Patrick M Chism</u>
Print Name of Water Well Contractor and License No.	Signature of Water Well Contractor

40300