

State Well Report

Part 1

Mississippi Department of Environmental Quality
Office of Land and Water Resources
P.O. Box 10631
Jackson, MS 39289-0631
(601)961-5210
(601)354-6938 (fax)

County: Leflore
Permit #: GW 41164
Irrigation Equipment
Driller: _____
Date drilling completed: 6-21-06

For Office Use Only:
Aquifer: _____
Well #: J-153
L. S. Elevation: _____
E-log #: _____

State Law requires that this report be prepared by the driller in detail and filed with the Department within 30 days of completion of drilling of the well.

Well Owner Information	Well Location
Owner Name: <u>Ray Makamson</u>	Latitude: <u>33° 31' 38.3"</u> , Longitude: <u>90° 21' 06.9"</u>
Mailing Address: <u>7575 County Road 144</u>	Method of Lat/Long (circle one): <u>Conventional Survey</u> , <u>USGS quad</u> , <u>Hand-held GPS</u> , <u>Survey-grade GPS</u>
<u>Itta Bena MS 38941</u>	<u>NE 1/4 Sec 12 Twn 19N Rng 2W</u>
City State Zip Code	Distance Direction Nearest Town <u>3 Miles NW of Itta Bena</u>
Telephone No. () _____	

Well Data

Purpose of Well (circle one) Home Industrial Public Supply Irrigation Fish Culture Other replacement GW-3825

Date well drilling started: 6-21-06 Date well drilling completed: 6-21-06

If flowing, method of flow regulation: Valve _____ Other (describe) _____

Static Water Level: 47' feet above or below (circle one) land surface Date measured: 6-22-06

Method of Measurement (circle one) steel tape electric tape air line other: _____

Hole depth: 125 Well depth: 125 Well grouted to a depth of 10 feet

Type of grout (circle one): Cement Bentonite Mix

Casing length: 85 feet Casing diameter: 16 inches Type of casing: PVC Sch. 40

Screen length: 40 feet Screen diameter: 16 inches Type of screen: PVC Sch. 40

Screen slot size: .050 inches Setting depth: From 86 feet to 125 feet

Type of completion (circle all applicable): Gravel packed Underreamed Telescoped Open hole Natural Development
Other (describe): _____

Top of lap pipe or reduction in casing: _____ feet. If telescoped or more than one screen, describe on back of page

Logs run (circle all applicable): No log run Electric Gamma Ray Density Sonic Neutron Other: _____

Name of organization running log(s): _____

I certify that the well was drilled, constructed, and completed in accordance with all applicable requirements of the Mississippi Department of Environmental Quality and/or the Mississippi Department of Health regulations and state laws.

Irrigation Equipment Inc.
Patrick M. Chism 0695

Print Name of Water Well Contractor and License No.

Signature of Water Well Contractor

Patrick M. Chism

RECEIVED

Ref# 41164

JUL 24 2006

YMD JOINT WATER
MANAGEMENT DISTRICT

State Well Report

Part 1

Mississippi Department of Environmental Quality
Office of Land and Water Resources
P.O. Box 10631
Jackson, MS 39289-0631
(601)961-5210
(601)354-6938 (fax)

County: Leflore
Permit #: 60041169
Irrigation Equipment
Driller: _____
Date drilling completed: 6-21-06

For Office Use Only:
Aquifer: _____
Well #: J-153
L. S. Elevation: _____
E-log #: _____

State Law requires that this report be prepared by the driller in detail and filed with the Department within 30 days of completion of drilling of the well.

Well Owner Information	Well Location
Owner Name: <u>Ray Makamson</u>	Latitude: <u>33 31 38.3</u> , Longitude: <u>90 21 06.9</u>
Mailing Address: <u>7575 County Road 144</u>	Method of Lat/Long (circle one): <u>38</u> Conventional Survey, <u>07</u>
<u>Itta Bena MS 38941</u>	USGS quad, Hand-held GPS, Survey-grade GPS
City State Zip Code	<u>NE 1/4 SE 1/4 Sec 12 Twn 19N Rng 2W</u>
Telephone No. () _____	Distance Direction Nearest Town <u>3 Miles NW of Itta Bena</u>

Well Data

Purpose of Well (circle one) Home Industrial Public Supply Irrigation Fish Culture Other replacement

Date well drilling started: 6-21-06 Date well drilling completed: 6-21-06

If flowing, method of flow regulation: Valve _____ Other (describe) _____

Static Water Level: 47' feet above or below (circle one) land surface Date measured: 6-22-06

Method of Measurement (circle one) steel tape electric tape air line other: _____

Hole depth: 125 Well depth: 125 Well grouted to a depth of 10 feet

Type of grout (circle one): Cement Bentonite Mix

Casing length: 85 feet Casing diameter: 16 inches Type of casing: PVC Sch. 40

Screen length: 40 feet Screen diameter: 16 inches Type of screen: PVC Sch. 40

Screen slot size: .050 inches Setting depth: From 86 feet to 125 feet

Type of completion (circle all applicable): Gravel packed Underreamed Telescoped Open hole Natural Development
Other (describe): _____

Top of lap pipe or reduction in casing: _____ feet. If telescoped or more than one screen, describe on back of page

Logs run (circle all applicable): No log run Electric Gamma Ray Density Sonic Neutron Other: _____

Name of organization running log(s): _____

I certify that the well was drilled, constructed, and completed in accordance with all applicable requirements of the Mississippi Department of Environmental Quality and/or the Mississippi Department of Health regulations and state laws.

Irrigation Equipment Inc.
Patrick M. Chism 0695

Patrick M Chism
Signature of Water Well Contractor

Print Name of Water Well Contractor and License No.

RECEIVED
JUL 10 2006
BY: OLWF

J.

If well telescopes please sketch below and show depths.


Ground Level

Description of Formations Encountered	From	To
Clay	0	19
Fine Sand	20	35
Fine Sand/gravel	36	49
Med. Sand/gravel	50	125

Old Well 20' West

If more than one screen, show location of each on sketch

Sketch the property layout and include the following: 1) the well location; 2) any permanent structures on the property that may aid in locating the well; 3) any roads, power lines, or other items that may aid in locating the property and the well; 4) indicate direction.

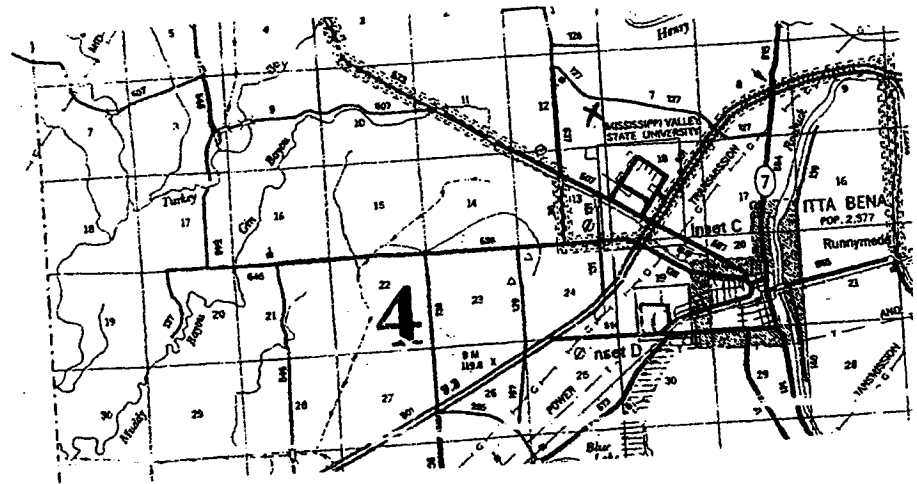

Landowner Name: _____

Pat M. Chris

 Signature of Water Well Contractor

STATE WELL REPORT

Part 2

Pump Installer's Completion Report
 Mississippi Department of Environmental Quality
 Office of Land and Water Resources
 P.O. Box 10631
 Jackson, MS 39289-0631
 (601)961-5210
 (601)354-6938 (fax)

County: Leflore
 Permit #: 0000000000
 Irrigation Equipment
 Driller: _____
 Date completed: 6-21-06
Copy information from block on Part 1

For Office Use Only:

Aquifer: _____
 Well #: J-153
 Elevation: _____

This part of the report must be completed by a licensed water well contractor or a licensed pump installer. A copy of Part 1 of the report must be attached and both parts filed with the Department at the above address within 30 days of well completion.

Well Owner Information	Well Location
Owner Name: <u>Ray Makamson</u>	Latitude: _____ Longitude: _____
Mailing Address: <u>7575 County Road 144</u>	Method of Lat/Long (check one): Conventional Survey _____
<u>Itta Bena MS 38941</u>	USGS quad _____ Hand-held GPS _____ Survey-grade GPS _____
City State Zip Code	<u>NE ¼ SE ¼ Sec 12 T19N R 2W</u>
Telephone No. (____) _____	Distance Direction Nearest Town
	<u>3 Miles NW of Itta Bena</u>

Pump Type Circle one	Power Type Circle one
Air Lift Jet <input type="checkbox"/> Submersible <input checked="" type="checkbox"/>	Diesel Engine <input type="checkbox"/> Gasoline Engine <input type="checkbox"/> Natural Gas <input type="checkbox"/>
Bucket Piston <input type="checkbox"/> Turbine <input checked="" type="checkbox"/>	Electric Motor <input checked="" type="checkbox"/> Hand <input type="checkbox"/> Tractor PTO <input type="checkbox"/>
Centrifugal Rotary <input type="checkbox"/> Flowing Well <input type="checkbox"/>	Windmill <input type="checkbox"/> Other (specify): _____
Other (specify): _____	Horse Power Rating of Motor: <u>60</u>
Date Pump Installed: <u>6-22-06</u>	Setting Depth: <u>70</u> feet
Rated Pump Capacity: <u>2500-3000</u> Gallons Per Minute	Number of Stages: <u>1</u>

Pump Test Data	Method of Measuring Water Level Circle one
Date Well Tested: _____	Air Line <input type="checkbox"/> Electric Measuring Line <input type="checkbox"/> Steel Tape <input type="checkbox"/>
Static Water Level (A): _____ Feet Below Land Surface	Other (specify): _____
Pumping Water Level (B): _____ Feet Below Land Surface	For flowing well, measured shut in head: _____ feet
Drawdown [(B) - (A)]: _____ Feet Below Land Surface	Well yielded _____ GPM with a drawdown of _____ feet after _____ hours of pumping
Test Pumping Rate: _____ Gallons Per Minute	
Duration of Pump Test (minimum 4 hours): _____ hours	

I HEREBY CERTIFY that the above statements are true to the best of my knowledge.

Patrick M. Chism 0695
 Print Name of Pump Installer and License No. (if applicable) Signature of Pump Installer

RECEIVED

Form: OLWR-SWR-1B
 BY: OLWR