

State Well Report

Part 1

Mississippi Department of Environmental Quality
 Office of Land and Water Resources
 P.O. Box 10631
 Jackson, MS 39289-0631
 (601)961-5210
 (601)354-6938 (fax)

For Office Use Only:

Aquifer: _____
 Well #: J-154
 L. S. Elevation: _____
 E-log #: _____

County: Leflore
 Permit #: 6W 41311
 Irrigation Equipment
 Driller: _____
 Date drilling completed: 9-1-06

State Law requires that this report be prepared by the driller in detail and filed with the Department within 30 days of completion of drilling of the well.

Well Owner Information	Well Location
Owner Name: <u>Scotland Fisheries</u>	Latitude: <u>33° 31' 30.3" N</u> , Longitude: <u>90° 23' 47.0" W</u>
Mailing Address: <u>22550 County Road 507</u>	Method of Lat/Long (circle one): <u>Conventional Survey</u>
	USGS quad, Hand-held GPS, Survey-grade GPS
<u>Itta Bena MS 38941</u>	NW 1/4 SW 1/4 Sec <u>10</u> Twn <u>19N</u> Rng <u>2W</u>
City: _____ State: _____ Zip Code: _____	Distance: <u>4</u> Miles Direction: <u>NW</u> of Nearest Town: <u>Itta Bena</u>
Telephone No. (____) _____	

Pond 8-9-10-11

Purpose of Well (circle one) Home Industrial Public Supply Irrigation Fish Culture Other Replacement

Date well drilling started: 9-1-06 Date well drilling completed: 9-1-06

If flowing, method of flow regulation: Valve _____ Other (describe) _____

Static Water Level: 55' feet above of below (circle one) land surface Date measured: 9-5-06

Method of Measurement (circle one) steel tape electric tape air line other: _____

Hole depth: 135' Well depth: 135' Well grouted to a depth of 10 feet

Type of grout (circle one): Cement Bentonite Mix

Casing length: 95 feet Casing diameter: 16 inches Type of casing: PVC Sch. 40

Screen length: 40 feet Screen diameter: 16 inches Type of screen: PVC Sch. 40

Screen slot size: .050 inches Setting depth: From 96 feet to 135 feet

Type of completion (circle all applicable): Gravel packed Underreamed Telescoped Open hole Natural Development
 Other (describe): _____

Top of lap pipe or reduction in casing: _____ feet. If telescoped or more than one screen, describe on back of page

Logs run (circle all applicable): No log run Electric Gamma Ray Density Sonic Neutron Other: _____

Name of organization running log(s): _____

I certify that the well was drilled, constructed, and completed in accordance with all applicable requirements of the Mississippi Department of Environmental Quality and/or the Mississippi Department of Health regulations and state laws.

Irrigation Equipment Inc.
 Patrick M. Chism 0695

Patrick M. Chism

Print Name of Water Well Contractor and License No.

Signature of Water Well Contractor

RECEIVED

SEP 18 2006

BY: OLWR

STATE WELL REPORT

Part 2

Pump Installer's Completion Report
 Mississippi Department of Environmental Quality
 Office of Land and Water Resources
 P.O. Box 10631
 Jackson, MS 39289-0631
 (601)961-5210
 (601)354-6938 (fax)

County: Leflore
 Permit #: GW 41311
 Irrigation Equipment
 Driller: _____
 Date completed: 9-1-06
Copy information from block on Part 1

For Office Use Only:

Aquifer: _____
 Well #: J-154
 Elevation: _____

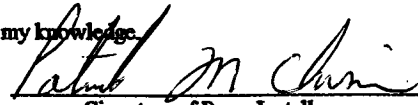
This part of the report must be completed by a licensed water well contractor or a licensed pump installer. A copy of Part 1 of the report must be attached and both parts filed with the Department at the above address within 30 days of well completion.

Well Owner Information	Well Location
Owner Name: <u>Scotland Fisheries</u> Mailing Address: <u>22550 County Road 507</u> _____ <u>Itta Bena MS 38941</u> City State Zip Code Telephone No. () _____	Latitude: _____ Longitude: _____ Method of Lat/Long (check one): Conventional Survey ____, USGS quad ____, Hand-held GPS ____, Survey-grade GPS ____, <u>NW ¼ SW ¼ Sec 10 T19N R 2W</u> Distance Direction Nearest Town <u>4 Miles NW of Itta Bena</u>

Pump Type Circle one	Power Type Circle one
Air Lift Jet Submersible Bucket Piston <u>Turbine</u> Centrifugal Rotary Flowing Well Other (specify): _____ Date Pump Installed: <u>9-5-06</u> Rated Pump Capacity: <u>2300</u> Gallons Per Minute	Diesel Engine Gasoline Engine Natural Gas <u>Electric Motor</u> Hand Tractor PTO Windmill Other (specify): _____ Horse Power Rating of Motor: <u>60</u> Setting Depth: <u>80</u> feet Number of Stages: <u>2</u>

Pump Test Data	Method of Measuring Water Level Circle one
Date Well Tested: _____ Static Water Level (A): _____ Feet Below Land Surface Pumping Water Level (B): _____ Feet Below Land Surface Drawdown [(B) - (A)]: _____ Feet Below Land Surface Test Pumping Rate: _____ Gallons Per Minute Duration of Pump Test (minimum 4 hours): _____ hours	Air Line Electric Measuring Line Steel Tape Other (specify): _____ For flowing well, measured shut in head: _____ feet Well yielded _____ GPM with a drawdown of _____ feet after _____ hours of pumping

I HEREBY CERTIFY that the above statements are true to the best of my knowledge.
Patrick M. Chism 0695
 Print Name of Pump Installer and License No. (if applicable)


 Signature of Pump Installer

RECEIVED

Form: OLWR/SWR-18 2006

BY: OLWR