

37-32-07 90-26-12

MISSISSIPPI DEPARTMENT OF ENVIRONMENTAL QUALITY

Office of Land and Water Resources

P. O. Box 10631
 Jackson, MS 39289-0631
WATER WELL DRILLERS LOG

COUNTY WELL LOCATED
LEFLORE

WELL NUMBER **2** CODED

J-163

DATE WELL COMPLETED
6/15/02

PERMIT NUMBER

NAME OF DRILLING FIRM
ALford Irrig

NAME & MAILING ADDRESS OF LANDOWNER
BARNHAM AG. SERVICE

ITTA BENA

WELL LOCATION: SEC **6** TOWNSHIP **T19** RANGE **R2**

SE/SE **E** of **ITTA BENA**

DISTANCE **2** Miles DIRECTION **E** NEAREST TOWN

OTHER LANDMARK

WELL PURPOSE: Home, Irrigation, Municipal, Industrial, Fish Pond, etc.

PUMP DATA

PUMP TYPE (Circle One):
 Submersible, **Turbine** Jet Flowing Well,
 Other (Describe)

POWER TYPE (Circle One):
 Electric, Tractor, **Diesel**, Gasoline, Butane,
 Other (Describe) H/P **60**

Pump Capacity (GPM) **2500** No. of Stages **2** Setting Depth **60** FT.

PUMP TEST

Well yielded _____ GPM with
 a drawdown of _____ ft.
 after _____ hours of pumping

WELL DATA

Well Depth 125	Casing Diameter (In.) 1 1/2	Casing Length (Ft.) 85
Type of Casing PVC	Hole Depth 125	Depth to Static Water Level

TYPE OF COMPLETION: (Circle One or More):
 Gravel Packed, Underreamed, Telescoped,
 Natural Development, Open Hole, Other

LOG DATA

TYPE OF LOG RUN (Circle One):
 Electric, Gamma Ray, Density, Sonic, Neutron,
 Other (Describe) **No Log Run**

Name of Organization Running Log

WELL GROUTED TO A DEPTH OF _____ FEET
 Type Grout (circle one): Cement, Bentonite, or Mix

GEOLOGIC DATA (Office Use Only)

Surface Elev.	Geologic Unit	Unit Thickness	Depth to Top
Subs. SWL	Date	Analysis	Aquifer Test

Driller's Remarks

SCREEN DATA

Diameter - Inches 1 1/2	Length - Feet 40	Slot Size - Inches 32
Screen Type PVC	Depth to Bottom - Feet 125	


DESCRIPTION OF FORMATIONS ENCOUNTERED	FROM	TO	FORMATIONS (Continued)	FROM	TO
CLAY	0	18			
FINE SAND	18	27			
SAND & GRAVEL	27	125			

RECEIVED
FEB 18 2003
BY: OLWR

IF MORE SPACE IS NEEDED, USE BACK

If well telescopes please sketch and show depths.

GROUND LEVEL

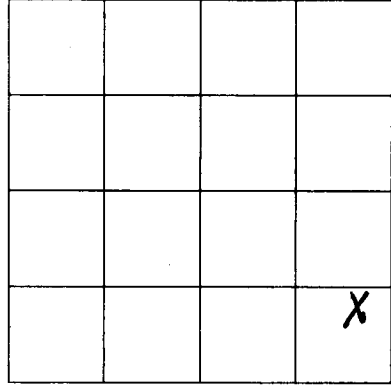

SECTION 6

Please indicate well location X.

ADDITIONAL INFORMATION

If more than one screen,
show location of each on sketch.
