

MISSISSIPPI DEPARTMENT OF NATURAL RESOURCES

Bureau of Land and Water Resources

Southport Mall

P.O. Box 10631

Jackson, Mississippi 39209

WATER WELL DRILLERS LOG

LEFLORE
J SDI

10/2/85 date well completed

J & K Irrigation firm name

LeFlore county well located

LANDOWNER: Dough CLARK

ITTA BERRA

(mailing address)

WELL LOCATION:

sec. 14 T. 19 N R. 2 E
3 1/2 miles W of ITTA Berra

WELL PURPOSE: IRRIGATION
(home, irrigation, municipal, industrial)

WELL COMPLETION DATA:


- (1) diameter (inches) 10
(2) total depth (feet) 117
(3) static water level (feet) 24 below top of ground
(4) casing PVC 22
(5) screen 20
(6) pump 20 HP 1200 yield gpm
(7) electric log NO

(organization running log)

(8) how well bottom plugged CAP

DRILLERS REMARKS:


Table with columns: description of formations encountered, from, to. Rows: CLAY (0-13), FINE SAND (13-28), SAND & GRAVEL (28-117).

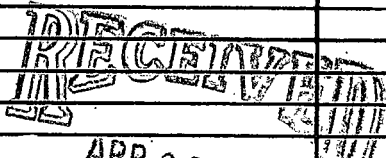

Department of Natural Resources
Bureau of Land & Water Resources

If well telescopes please sketch and show depths.

GROUND LEVEL

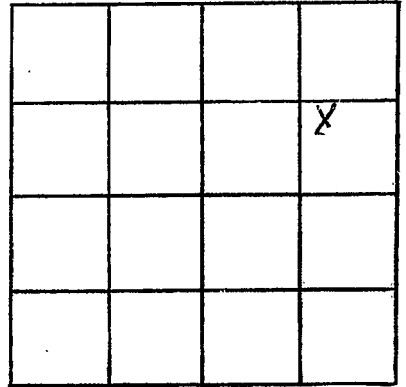

SECTION 14

Please indicate well location X.

ADDITIONAL INFORMATION

If more than one screen,  
show locations of each on sketch.