

MISSISSIPPI DEPARTMENT OF NATURAL RESOURCES
Bureau of Land and Water Resources
 Southport Mall
 P.O. Box 10631
 Jackson, Mississippi 39209
WATER WELL DRILLERS LOG

Leflore
 J-100

March 26 1982 Laramie well & pump Leflore
 date well completed firm name county well located

LANDOWNER: Roger K. Haydon
 (Larry Bennett)
 Itta Bena MS
 (mailing address)

| description of formations encountered | from | to |
|---------------------------------------|------|-----|
| clay | 0 | 20 |
| fine sand | 20 | 40 |
| med. sand | 40 | 60 |
| coarse sand & gravel | 60 | 116 |

WELL LOCATION:
 sec 26 T 19 N R 2 E
 S W
 7 miles East of Morehead
 (distance) (direction) (nearest town)

WELL PURPOSE:
 (home, irrigation, municipal, industrial)

WELL COMPLETION DATA:

- (1) diameter (inches) 16"
- (2) total depth (feet) 116'
- (3) static water level (feet) 27' below
 top of ground. above
- (4) casing steel, 76'
 (material) (depth)
 (size) if telescope see back.
- (5) screen 40 76'
 (length) (depth to top)
16" Steel
 (size) (material)
- (6) pump 60 3000
 (HP) (yield gpm)
 (type power)
- (7) electric log No
 (yes or no)
 (organization running log)
- (8) how well bottom plugged Steel
Plate

DRILLERS REMARKS:


DEPT. OF NATURAL RESOURCES
 BUREAU OF LAND & WATER RESOURCES

JUN 24 1992

RECEIVED

If well telescopes please sketch and show depths.

GROUND LEVEL

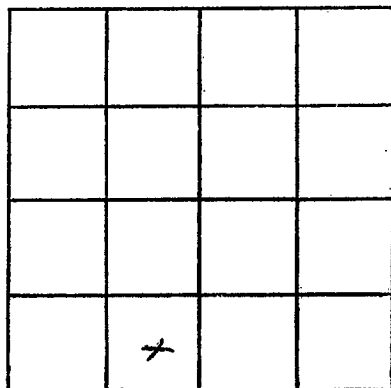

SECTION 26

Please indicate well location X.

ADDITIONAL INFORMATION

If more than one screen,
show locations of each on sketch.