

Leflore MISSISSIPPI BOARD OF WATER COMMISSIONERS

J-1002

3-14-62

WATER WELL DRILLERS LOG

Date: 3-14, 1962, Driller: PITANG GAS CO OF C. WOOD County LEFLORE (Name)

(1) Owner of Land: E.D. STRAIN JR (Name)

MORGAN CITY MISS. (Address)

(2) Location: 1/4, 1/4, Sec. T R

4 miles EAST, of MORGAN (distance) (direction) (Nearest Town)

(3) Topography: LEVEL (Hilly) (Flat) (Level)

(4) Purpose of Well: IRRIGATION (Domestic Irrigation, Municipal, Industrial, Other)

Information upon completion of well:

(1) Diameter: 6 inches.

(2) Total Depth: 90 feet.

(3) Water Level: 10 feet below top of ground.

(4) Cased to: 42', Size: 6"

(5) Screen: Size: 6", Length: 48"

(6) Were any formations sealed against pollution?


yes, X no.

If YES, depth of formation

Why

Drillers Remarks:

Description & Color of Materials Sand, Clay, Red Clay, Shell, etc.	Thick- ness Feet	Depth Feet
BLUE CLAY	20	20
WHITE SAND	17	37
COARSE SAND	17	54
C. SAND + PEN ROCK	21	75
PEN ROCK + ROCK	15	90

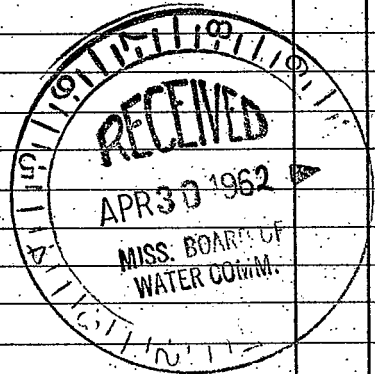

(Use Back Side)

Well No.

Handwritten text at the top of the page, including a header and several lines of cursive script.

Second section of handwritten text, appearing as a list or series of entries.

Third section of handwritten text, continuing the list or entries.

Fourth section of handwritten text, showing more entries.

Fifth section of handwritten text, continuing the list.

Final section of handwritten text at the bottom of the page.