

MISSISSIPPI DEPARTMENT OF NATURAL RESOURCES

Bureau of Land and Water Resources

Southport Mail

P.O. Box 10631

Jackson, Mississippi 39209

WATER WELL DRILLERS LOG

Permit
11691-CMG-031289
MS-GW-11691
52002

148A

4-18 1989
date well completed

Dyn Well
firm name

Let Love
county well located

LANDOWNER: C. H. Murphy Jr

description of formations encountered

from

to

P.O. Box 492

IHA Bena Ms. 38941
(mailing address)

CLAY
Fine Sand + Gravel
Sand + Gravel
Fine Sand

0 31
31 86
86 98
98 100

WELL LOCATION:

sec. 29 T 19 N R 2 E
S W
6 miles NW of IHA BENA
(distance) (direction) (nearest town)

WELL PURPOSE: Irrigation
(home, irrigation, municipal, industrial)

WELL COMPLETION DATA:

- (1) diameter (inches) 16"
- (2) total depth (feet) 98' well
- (3) static water level (feet) below above top of ground.
- (4) casing steel 138' ll
(material) (depth)
16" if telescope see back.
(size)
- (5) screen 40'
(length) (depth to top)
46" (size) (material)
- (6) pump 40 2500
(HP) (yield gpm)
Electric (type power)
- (7) electric log No
(yes or no)
None (organization running log)
- (8) how well bottom plugged Plate


RECEIVED
APR 20 1989

Department of Natural Resources
Bureau of Land & Water Resources

DRILLERS REMARKS:

If well telescopes please sketch and show depths.

GROUND LEVEL

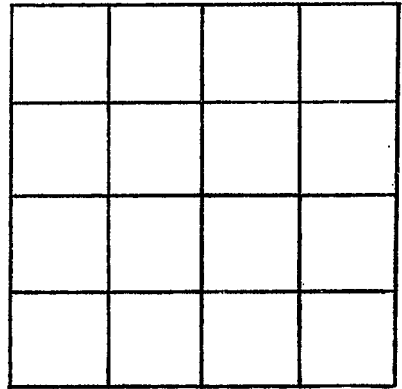

SECTION _____

Please indicate well location X.

ADDITIONAL INFORMATION

If more than one screen, show locations of each on sketch.