

MISSISSIPPI DEPARTMENT OF ENVIRONMENTAL QUALITY

Office of Land and Water Resources

P. O. Box 10631

Jackson, MS 39289-0631
WATER WELL DRILLERS LOG

COUNTY WELL LOCATED	
Leflore	
WELL NUMBER	CODED
J 2025	
DATE WELL COMPLETED	
9-15-97	

PERMIT NUMBER
NAME OF DRILLING FIRM
Irrigation Equipment Inc. Jackson, MS 39289-0631
Indianola, MS

NAME & MAILING ADDRESS OF LANDOWNER
Fondren Property
c/o Tackett Farms
Rt.1, Box 187

Schlater, MS 38952

WELL LOCATION:	SEC	TOWNSHIP	RANGE
NE/SE	27	19N	N 2W E
		S	W

DISTANCE	DIRECTION	NEAREST TOWN
2 Miles	SW	Ida Bena

OTHER LANDMARK

WELL PURPOSE: Home, Irrigation, Municipal, Industrial, Fish Pond, etc.
Irrigation

WELL DATA		
Well Depth	Casing Diameter (In.)	Casing Length (Ft.)
127	16	77
Type of Casing	Hole Depth	Depth to Static Water Level
PVC	127	

TYPE OF COMPLETION: (Circle One or More):
Gravel Packed Underreamed, Telescoped, Natural Development, Open Hole, Other (Describe)

WELL GROUTED TO A DEPTH OF _____ FEET
Type Grout (circle one): Cement, Bentonite, or Mix

SCREEN DATA		
Diameter - Inches	Length - Feet	Slot Size - Inches
16	50	.050
Screen Type	Depth to Bottom - Feet	
PVC	127	

DESCRIPTION OF FORMATIONS ENCOUNTERED	FROM	TO
Clay	0	30
Fine Sand	30	45
Fine Sand & Gravel	45	60
Med. Sand & Gravel	60	127

PUMP DATA

PUMP TYPE (Circle One):	Jet	Flowing Well,
Submersible, Turbine, Other (Describe)		

POWER TYPE (Circle One):	Tractor, Diesel, Gasoline, Butane,
Electric, Other (Describe)	H/P 60

Pump Capacity (GPM)	No. of Stages	Setting Depth
3000	1	70 FT.

PUMP TEST
Well yielded _____ GPM with a drawdown of _____ ft. after _____ hours of pumping

LOG DATA

TYPE OF LOG RUN (Circle One):	No Log Run,
Electric, Gamma Ray, Density, Sonic, Neutron, Other (Describe)	

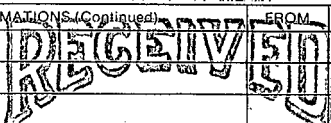
Name of Organization Running Log

GEOLOGIC DATA (Office Use Only)

Surface Elev.	Geologic Unit	Unit Thickness	Depth to Top
Subs. SWL	Date	Analysis	Aquifer Test

Driller's Remarks

Top of Lap Pipe or Reduction in Casing
FEET
IF TELESCOPED OR MORE THAN ONE SCREEN: USE BACK PAGE

FORMATIONS (Continued)	FROM	TO
		
OCT 29 1997		
Dept. of Environmental Quality Office of Land & Water Resources		
IF MORE SPACE IS NEEDED, USE BACK		

If well telescopes please
sketch and show depths.

GROUND LEVEL

			x

SECTION 27

Please indicate well location X.

ADDITIONAL INFORMATION

If more than one screen,
show location of each on sketch.