

MISSISSIPPI DEPARTMENT OF ENVIRONMENTAL QUALITY

Office of Land and Water Resources

P. O. Box 10631
Jackson, MS 39289-0631
WATER WELL DRILLERS LOG

COUNTY WELL LOCATED Leflore	
WELL NUMBER J 2065	CODED
DATE WELL COMPLETED 7-28-99	

PERMIT NUMBER
NAME OF DRILLING FIRM IRRIGATION EQUIPMENT
601/887-2555
INDIANOLA, MS

NAME & MAILING ADDRESS OF LANDOWNER Scotland Fisheries			
Rt. 1, Box 170-L			
ITTA BENA, MS 38941			
WELL LOCATION:	SEC	TOWNSHIP	RANGE
NE/SW	3	19 ^N _S	2 ^E _W
DISTANCE	DIRECTION	NEAREST TOWN	
4 Miles	NW	of ITTA BENA	
OTHER LANDMARK			
WELL PURPOSE: Home, Irrigation, Municipal, Industrial, Fish Pond, etc. Fish pond			

PUMP DATA		
PUMP TYPE (Circle One): Submersible, <u>Urth</u> , Jet, Flowing Well, Other (Describe) _____		
POWER TYPE (Circle One): <u>Electric</u> , Tractor, Diesel, Gasoline, Butane, Other (Describe) _____ H/P <u>60</u>		
Pump Capacity (GPM) 2500	No. of Stages 1	Setting Depth 70 FT.
PUMP TEST		
Well yielded _____ GPM with a drawdown of _____ ft. after _____ hours of pumping		

WELL DATA		
Well Depth 115	Casing Diameter (In.) 16	Casing Length (Ft.) 75
Type of Casing PVC	Hole Depth 115	Depth to Static Water Level 48 Ft.
TYPE OF COMPLETION: (Circle One or More): <u>Gravel Packed</u> , Underreamed, Telescoped, Natural Development, Open Hole, Other (Describe) _____		
WELL GROUTED TO A DEPTH OF _____ FEET Type Grout (circle one): Cement, Bentonite, or Mix		

LOG DATA	
TYPE OF LOG RUN (Circle One): Electric, Gamma Ray, Density, <u>Sonic</u> , Neutron, Other (Describe) _____	
Name of Organization Running Log	

SCREEN DATA		
Diameter - Inches 16	Length - Feet 40	Slot Size - Inches .050
Screen Type PVC	Depth to Bottom - Feet 115	

GEOLOGIC DATA (Office Use Only)			
Surface Elev.	Geologic Unit	Unit Thickness	Depth to Top
Subs. SWL	Date	Analysis	Aquifer Test
Driller's Remarks			
Top of Lap Pipe or Reduction in Casing			
FEET		IF TELESCOPED OR MORE THAN ONE SCREEN: USE BACK PAGE	

DESCRIPTION OF FORMATIONS ENCOUNTERED	FROM	TO	FORMATIONS (Continued)	
			FROM	TO
CLAY	0	38		
FINE SAND + GRAVEL	38	50		
FINE SAND	50	65		
FINE SAND + GRAVEL	65	85		
med. SAND + GRAVEL	85	115		

RECEIVED


SEP 13 1999

**Dept. of Environmental Quality
Office of Land & Water Resources**

IF MORE SPACE IS NEEDED, USE BACK

If well telescopes please sketch and show depths.

GROUND LEVEL

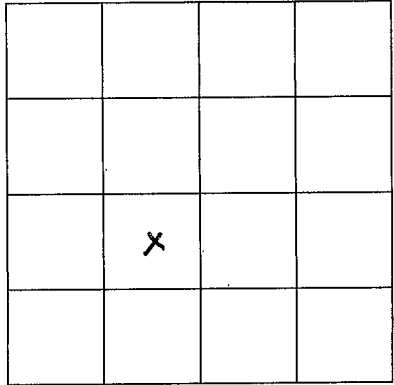

SECTION 3

Please indicate well location X.

ADDITIONAL INFORMATION

If more than one screen,
show location of each on sketch.