

K  
10-16-64

WATER WELL DRILLERS LOG CODED

Date: OCT 16, 1964, Driller: DELTA DRILLING Co. County LEFLORE  
(Name)

(1) Owner of Land: JAMES D. GREEN  
(Name)  
ITTA BENA, MISS.  
(Address)

(2) Location: SW 1/4, NE 1/4, Sec. 5 T24N W4E  
\_\_\_\_\_ miles \_\_\_\_\_ of \_\_\_\_\_  
(distance) (direction) (Nearest Town)

(3) Topography: \_\_\_\_\_  
(Hilly) (Flat) (Level)

(4) Purpose of Well: DOMESTIC  
(Domestic Irrigation  
Municipal, Industrial, Other)

Description & Color of Materials Sand, Clay, Red Clay, Shell, etc.	Thick- ness Feet	Depth Feet
GUMBO -	42	42
SAND	20	62
GRAVEL	74	136
GUMBO	118	254
SAND	156	410
GUMBO	112	522
SHALE W/ROCK CODED	82	604
GUMBO	21	625
SHALE	15	640
GUMBO W/ROCK	20	660
GREEN SAND	59	719
SHALE	60	779
GUMBO	25	804
SHALE	55	859
SAND	30	889
SHALE	70	959
GUMBO	40	999
WHITE SAND	27	1026

Information upon completion of well:

(1) Diameter 3 inches.

(2) Total Depth 1026 feet.

(3) Water Level FLOWS feet below top of ground. 625' 3"


(4) Cased to 1006, Size 399' 2"

(5) Screen: Size 2", Length 20'  
SS, .012 GA

(6) Were any formations sealed against pollution?  
\_\_\_\_\_ yes, \_\_\_\_\_ no.

If YES depth of formation \_\_\_\_\_  
Why \_\_\_\_\_

Drillers Remarks: 18' LAP OF 2"  
IN 3" PIPE

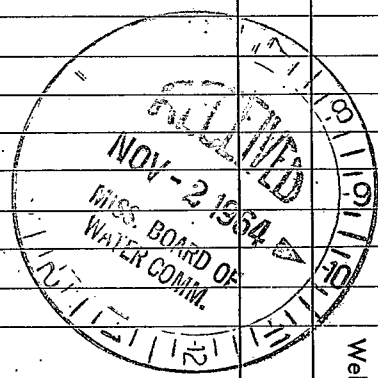

(Use Back Side)

Well No.

