

Leflore

WATER WELL DRILLERS LOG

[?]
CODED

K-3
7-27-61

Date: 7-27, 19 61, Driller: DELTA DRILLING CO. County LEFLORE
(Name)

(1) Owner of Land: ITTA BENA GIN CO.
(Name)
ITTA BENA, MISS.
(Address)

(2) Location: 1/4, 1/4, Sec. 20 T19R1W
_____ miles _____ of _____
(distance) (direction) (Nearest Town)

(3) Topography: _____
(Hilly) (Flat) (Level)

(4) Purpose of Well: _____
(Domestic Irrigation
Municipal, Industrial, Other)

Description & Color of Materials Sand, Clay, Red Clay, Shell, etc.	Thick- ness Feet	Depth Feet
SAND & GRAVEL	125	125
GUMBO	132	257
SAND	156	413
GUMBO	80	493
SAND w/4" ROCK	32	525
SHALE	11	536
SAND w/4" ROCK	39	575
SHALE	9	584
SAND	12	596
SHALE	11	607
SAND w/6" ROCK & 4" ROCK	37	644
SHALE w/4 & 6" ROCK	22	666
SAND w/SHALE STREAKS & 3 & 6" ROCK	34	700
SHALE w/5" ROCK	17	717
SAND w/4" ROCK	18	735
SHALE	65	800
SAND	30	830
SHALE	12	842
GREEN SAND w/5" ROCK	26	868
SHALE	4	892
SAND	10	902
SHALE w/3" ROCK	21	923
GREEN SAND w/6" ROCK	50	973
SHALE	11	984
SAND	18	1002
SHALE	13	1015
SAND	48	1063

Information upon completion of well:

(1) Diameter 3 inches.

(2) Total Depth 1063 feet.

(3) Water Level _____ feet below top of ground.

(4) Cased to 1063, Size 2 & 3"

(5) Screen: Size 2", Length 30


(6) Were any formations sealed against pollution?
_____ yes, _____ no.

If YES depth of formation _____

Why _____

Drillers Remarks: _____

CODED

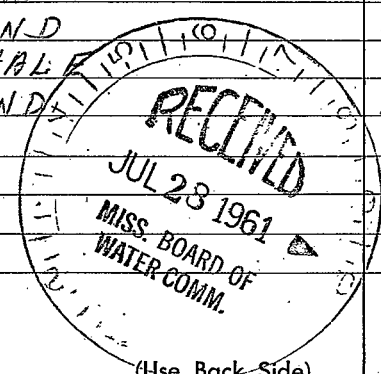

Well No.

1919

1919