

Leflore
 K-6 M K 4A ?
 4-9-65

MISSISSIPPI BOARD OF WATER COMMISSIONERS

WATER WELL DRILLERS LOG

KAA?

CODED

Date: APRIL 9, 1965, Driller: DELTA DRILLING Co. County LEFLORE

(Name)

(1) Owner of Land: G. F. AUST
 (Name) *Haley West*
ITTA BENA, MISS. *End Ed.*
 (Address)

(2) Location: 1/4, 1/4, Sec 20 T19R1W
 _____ miles _____ of _____
 (distance) (direction) (Nearest Town)

(3) Topography: _____
 (Hilly) (Flat) (Level)

(4) Purpose of Well: DOMESTIC
 (Domestic Irrigation
 Municipal, Industrial, Other)

Description & Color of Materials Sand, Clay, Red Clay, Shell, etc.	Thick- ness Feet	Depth Feet
GUMBO	22	22
SAND	30	52
GRAVEL	86	138
GUMBO	34	172
SAND	32	204
GUMBO	11	215
SAND	34	249
GUMBO	11	260
SHALE	22	282
GUMBO	12	294
SHALE	31	325
GUMBO	52	377
SHALE	32	409
GUMBO	185	594
SAND W/ROCK	20	614
SHALE	86	700
GREEN SAND W/ROCKS	62	762
SHALE	10	772
GREEN SAND W/ROCKS	180	902
SHALE	26	928
GUMBO	26	954
SHALE W/ROCKS	52	1006
SAND	26	1032
GUMBO	52	1084
SAND	78	1162

Information upon completion of well:

(1) Diameter 3 inches.

(2) Total Depth 1162 feet.

(3) Water Level FLOWS feet below top of ground. 3" - 700'


(4) Cased to 1142, Size 2" - 462'

(5) Screen: Size 2", Length 20'

(6) Were any formations sealed against pollution?
 _____ yes, _____ no.

If YES depth of formation _____
 Why _____

Drillers Remarks: 20' 2" LAP IN 3"
PIPE - 7' 2" TAIL PIPE
ON BOTTOM END OF WELL -
WELL FLOWS - 65 G.P.M.

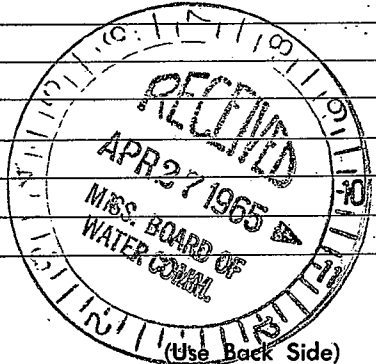

Well No.

