

LEFLORE
K8
9-8-72

MISSISSIPPI
BOARD OF WATER COMMISSIONERS
416 North State Street
Jackson, Mississippi 39201

WATER WELL DRILLERS LOG

CODED

9-8 1972 DYER WELL & IRRIGATION SERVICE LEFLORE
date well completed firm name county well located

LANDOWNER: GLENN W. Church
R.R.

description of formations
encountered

from to

GREENWOOD MISS.
(mailing address)

CLAY
SAND
SAND + GRAVEL
CLAY
SAND
SHALE + SAND ST.
SHALE + ROCK ST.
SAND

0 25
25 90
90 110
110 135
135 253
253 357
357 402
402 432

WELL LOCATION:

sec. 13 T 19 N R 1 E
2 miles SW of G-WOOD
(distance) (direction) (nearest town)

WELL PURPOSE: HOME
(home, irrigation, municipal, industrial)

WELL COMPLETION DATA:

- (1) diameter (inches) 3" x 2"
- (2) total depth (feet) 432'
- (3) static water level (feet) 4' below top of ground.
- (4) casing BK. IR. 422' (material) (depth)
#3 1/2" if telescope see back.
- (5) screen 10' 422' (length) (depth to top)
2" STAINLESS STEEL (size) (material)
- (6) pump 1/2 12 (HP) (yield gpm)
EVLB (type power)
- (7) electric log N/D (yes or no)

CODED

(organization running log)

(8) how well bottom plugged B.P.D.

OCT 17 1972


DRILLERS REMARKS:

MISS. DD. 6
FORM 10-6-61
LEGALLY REQUIRED

If well telescopes please sketch and show depths.

GROUND LEVEL

84' - 3" TOP CASING
338' - 2" LOWER CASING
10' - 2" SCREEN ALL
DIRECT COMPLET

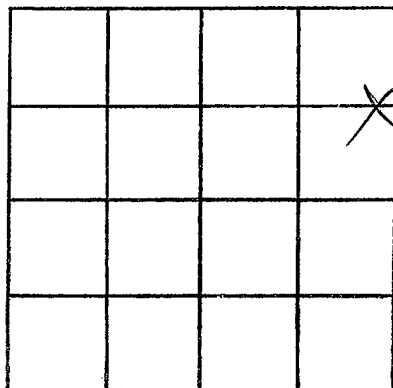

SECTION 13

Please indicate well location X.

ADDITIONAL INFORMATION

If more than one screen,
show locations of each on sketch.