

LEFLORE
K 11
3-1-73

MISSISSIPPI
BOARD OF WATER COMMISSIONERS
416 North State Street
Jackson, Mississippi 39201

CODED

WATER WELL DRILLERS LOG

LEFLORE

March 1 19 73 DYEER WELL & IRRIGATION SERVICE
date well completed firm name county well located

LANDOWNER: Jimmy Green

JTA BENA,

MISS.

(mailing address)

WELL LOCATION:

sec 4 T 19 N R 1 E
3 miles N of BENA
(distance) (direction) (nearest town)

WELL PURPOSE: Home
(home, irrigation, municipal, industrial)

WELL COMPLETION DATA:

- (1) diameter (inches) 4" x 2"
- (2) total depth (feet) 936'
- (3) static water level (feet) 200' below top of ground.
- (4) casing Bur-Tac 916' (material), (depth)
126' - 4" if telescope see back. 790' - 2"
- (5) screen 20' 916' (length), (depth to top)
2" STAINLESS STEEL (size), (material)
- (6) pump 1 1/2 (HP) 35 (yield gpm)
EUBC (type power)
- (7) electric log No (yes or no)
- (8) how well bottom plugged B.P.D.

description of formations encountered

from to

Clay	0	28
SAND	28	62
SAND & GRAVEL	62	142
Shale & Sand ST	142	282
SAND	282	432
Gummy Shale	432	452
hard Shale	452	488
Rock	488	490
Shale	490	514
Rock	514	516
Shale Sand Rock	516	677
Rock	677	678
Shale & Sand	678	712
Shale Sand Rock	712	869
Shale & Sand ST.	869	914
HD Sand	914	936

CODED


DRILLERS REMARKS:

JUN 27 1973

If well telescopes please sketch and show depths.

GROUND LEVEL

4" DIRECT COUPLER
WITH SWAGE WIPPLE

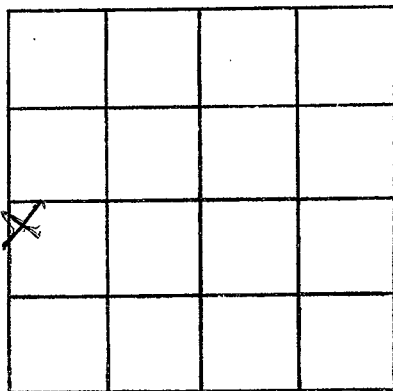

SECTION 4

Please indicate well location X.

ADDITIONAL INFORMATION

If more than one screen,
show locations of each on sketch.