

LEFLORE

K12

4-19-74

MISSISSIPPI
 BOARD OF WATER COMMISSIONERS
 416 North State Street
 Jackson, Mississippi 39201

CODED

WATER WELL DRILLERS LOG

DYER WELL & IRRIGATION SERVICE

LEFLORE

April 19 1974
date well completed

firm name

county well located

LANDOWNER:	description of formations encountered	from	to
R. L. Prewitt #1		CLAY	0
GREENWOOD MISS. (mailing address)	SAND	16	32
	SAND & PEAT BOULDER	32	42
WELL LOCATION: sec. <u>B-T 19</u> N R <u>14</u> E <u>2</u> miles <u>S.W.</u> of <u>GREENWOOD</u> (distance) (direction) (nearest town)	PEAT & SAND		
	GRAVEL		109
WELL PURPOSE: <u>IRRI</u> (home, irrigation, municipal, industrial)			
WELL COMPLETION DATA:			
(1) diameter (inches) <u>12"</u>			
(2) total depth (feet) <u>109</u>			
(3) static water level (feet) <u>17'</u> below above top of ground.			
(4) casing <u>PVC</u> , <u>69'</u> (material) (depth)			
<u>12"</u> (size) If telescope see back.			
(5) screen <u>40'</u> , <u>69'</u> (length) (depth to top)			
<u>12"</u> , <u>PVC</u> (size) (material)			
(6) pump <u>30</u> , <u>1800</u> (HP) (yield gpm)			
<u>ELECT</u> (type power)			
(7) electric log <u>No</u> (yes or no)			
(organization running log)			
(8) how well bottom plugged <u>PEAT</u>			
DRILLERS REMARKS:			


CODED

NOV 21 1974

MISS. BD. OF WATER COMMISSIONERS

If well telescopes please sketch and show depths.

GROUND LEVEL

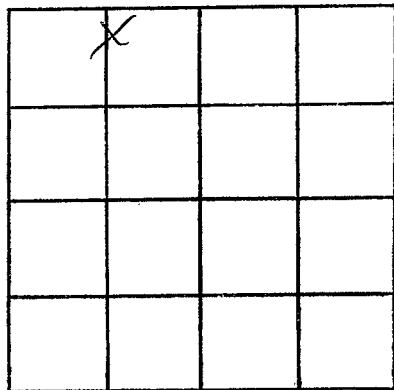

SECTION 13

Please indicate well location X.

ADDITIONAL INFORMATION

If more than one screen,
show locations of each on sketch.