

LEFLORE

K 13

4-21-74

MISSISSIPPI BOARD OF WATER COMMISSIONERS 416 North State Street Jackson, Mississippi 39201

CODED

WATER WELL DRILLERS LOG

DYER WELL & IRRIGATION SERVICE

LEFLORE

APRIL 21 1974 date well completed

firm name

county well located

LANDOWNER:

R. L. PILLON ET 2

description of formations encountered

from

to

GREENWOOD MISS. (mailing address)

CLAY 0 18 SAND 18 34 PEEL BACK SAND 34 110 GRAVEL 110

WELL LOCATION:

sec. 13 T 19 N R 1 E 2 miles S.W. of GREENWOOD (distance) (direction) (nearest town)

WELL PURPOSE: IRR. (home, irrigation, municipal, industrial)

WELL COMPLETION DATA:

- (1) diameter (inches) 12"
(2) total depth (feet) 110'
(3) static water level (feet) 18' below top of ground.
(4) casing PEEL BACK 70' (material), (depth) 12" (size) if telescope see back.
(5) screen 40' 70' (length), (depth to top) 12" PEEL BACK (size), (material)
(6) pump 30 (HP), 1800 (yield gpm)
(7) electric log No (yes or no)

CODED

(organization running log)

(8) how well bottom plugged PLATE


DRILLERS REMARKS:

NOV 21 1974

MISS. Bd. OF WATER COMMISSIONERS

If well telescopes please
sketch and show depths.

GROUND LEVEL

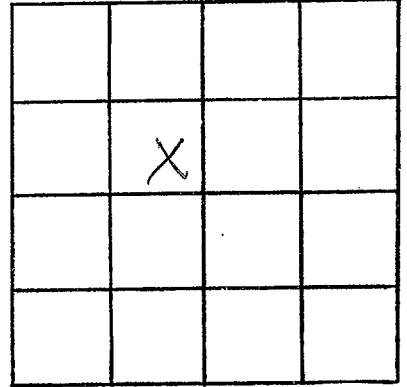

SECTION 13

Please indicate well location X.

ADDITIONAL INFORMATION

If more than one screen,
show locations of each on sketch.