

Leflore  
K 19  
6-7-62

MISSISSIPPI BOARD OF WATER COMMISSIONERS


WATER WELL DRILLING LOG

(18)

Date: JUNE 7, 1962, Driller: DELTA DRILLING Co. County LEFLORE

(Name)

(1) Owner of Land: <u>B. B. PROVINE, JR</u> (Name)	Description & Color of Materials Sand, Clay, Red Clay, Shell, etc.	Thick- ness Feet	Depth Feet
<u>ITTA BENA, MISS</u> (Address)	<u>CLAY</u>	<u>20</u>	<u>20</u>
(2) Location: <u>NE 1/4, SE 1/4, Sec. 7 T9N R1W</u>	<u>SAND</u>	<u>51</u>	<u>71</u>
<u>0.72</u> miles <u>W</u> of <u>Grand</u> (distance) (direction) (Nearest Town)	<u>GRAVEL</u>	<u>61</u>	<u>132</u>
(3) Topography: _____ (Hilly) (Flat) (Level)	<u>GUMBO</u>	<u>105</u>	<u>237</u>
(4) Purpose of Well: <u>DOMESTIC</u> (Domestic Irrigation Municipal, Industrial, Other)	<u>SHALE</u>	<u>195</u>	<u>432</u>
Information upon completion of well:	<u>SAND</u>	<u>35</u>	<u>467</u>
(1) Diameter <u>3</u> inches.	<u>GUMBO</u>	<u>78</u>	<u>545</u>
(2) Total Depth <u>1146</u> feet.	<u>SHALE</u>	<u>64</u>	<u>609</u>
(3) Water Level <u>WELL FLOWS</u> feet below top of ground.	<u>GREEN SAND</u>	<u>83</u>	<u>692</u>
(4) Cased to <u>1146</u> , Size <u>3+2"</u>	<u>SHALE</u>	<u>47</u>	<u>739</u>
Size <u>2"</u> , Length <u>20'</u>	<u>GREEN SAND</u>	<u>141</u>	<u>880</u>
(6) Were any formations sealed against pollution?	<u>GUMBO</u>	<u>16</u>	<u>896</u>
_____ yes, _____ no.	<u>SHALE</u>	<u>17</u>	<u>913</u>
If YES depth of formation _____	<u>SAND</u>	<u>33</u>	<u>946</u>
Why _____	<u>GUMBO</u>	<u>174</u>	<u>1070</u>
Drillers Remarks: _____	<u>WHITE SAND</u>	<u>76</u>	<u>1146</u>
_____			
_____			
_____			

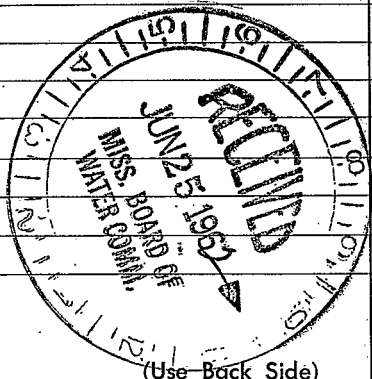

Well No.

