

CODED

LEFLORE

K 27

9-20-69

MISSISSIPPI
BOARD OF WATER COMMISSIONERS
416 North State Street
Jackson, Mississippi 39201

WATER WELL DRILLERS LOG
BUTANE GAS CO. OF GREENWOOD

9-20 19 69
date well completed

GREENWOOD, MISSISSIPPI
firm name

Leflore
county well located

LANDOWNER: L.W. Wade

Lake Kenay Plantation
Itta Bena, Miss.
(mailing address)

description of formations
encountered

from to

Clay	0	15
Sand	15	40
Sand & Gravel	40	90

WELL LOCATION:

sec. 30 T. 20 N R. 1 E
S W
4 1/2 miles N of Itta Bena
(distance) (direction) (nearest town)

WELL PURPOSE: Irrigation
(home, irrigation, municipal, industrial)

WELL COMPLETION DATA:

- (1) diameter (inches) 6"
- (2) total depth (feet) 90'
- (3) static water level (feet) 22' below above top of ground.
- (4) casing Steel, 50' (material) (depth)
6" (size) if telescope see back.
- (5) screen 40', 50' (length) (depth to top)
6" Steel (size) (material)
- (6) pump 40 HP, 1000 (yield gpm)
Diesel Tractor (type power)
- (7) electric log 50 (yes or no)

(organization running log)

(8) how well bottom plugged
Steel Plate


DRILLERS REMARKS:

OCT 15 1969

MISS. BD. OF
WATER COMAR

If well telescopes please sketch and show depths.

GROUND LEVEL

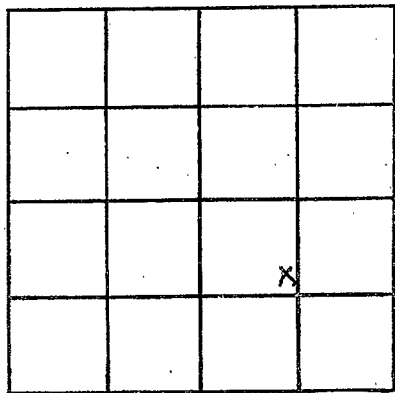

SECTION 30

Please indicate well location X.

ADDITIONAL INFORMATION

If more than one screen,
show locations of each on sketch.