

CODED

MISSISSIPPI
BOARD OF WATER COMMISSIONERS
416 North State Street
Jackson, Mississippi 39201

WATER WELL DRILLERS LOG

Leflore
R28
10-11-69

10/14/69 date well completed 19 Putnam Gas Co. of Wood firm name Leflore county well located

LANDOWNER:

Jim Moy

ITHA BENA MISS.
(mailing address)

WELL LOCATION:

sec. 19 T. 19 N. R. 1 E. S. 5 W.
1/2 miles W of ITHA BENA
(distance) (direction) (nearest town)

WELL PURPOSE:

Home
(home, irrigation, municipal, industrial)

WELL COMPLETION DATA:

- (1) diameter (inches) 2
- (2) total depth (feet) 619
- (3) static water level (feet) 5 below above top of ground.
- (4) casing Steel, 609,
(material) (depth)
2"
(size) if telescope see back.
- (5) screen 10', 609
(length) (depth to top)
2", Stainless Steel
(size) (material)
- (6) pump 3/4, 10
(HP) (yield gpm)
Elec.
(type power)
- (7) electric log NO
(yes or no)

(organization running log)

- (8) how well bottom plugged LEAD WOOL

description of formations encountered


from to

CLAY	0	24
SAND	24	72
SAND + Pea GRAVEL	72	119
Siltale	119	191
SAND	191	216
SHALE	216	325
SAND + Siltale	325	597
SAND	597	625
SHALE	625	645

OCT 20 1969

If well telescopes please sketch and show depths.

GROUND LEVEL

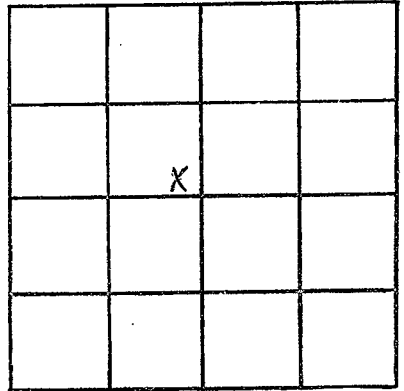

SECTION 17

Please indicate well location X.

ADDITIONAL INFORMATION

DRILLERS REMARKS