

LEFLORE
K 30
4/2/78

MISSISSIPPI
BOARD OF WATER COMMISSIONERS
416 North State Street
Jackson, Mississippi 39201

CODED


WATER WELL DRILLERS LOG

April 2, 1978 19 Reherson's Water Wells Laflore
date well completed firm name county well located

LANDOWNER:	description of formations encountered	from	to
S. J. Blochard R-1 B-145 Hattena, Mississippi (mailing address)	Clay Blue White coarse sand	0 40	40 100
WELL LOCATION: sec. 32 T 19 N R E S W 4 miles East of Moorehead (distance) (direction) (nearest town)			
WELL PURPOSE: (home, irrigation, municipal, industrial)	CODED		
WELL COMPLETION DATA: (1) diameter (inches) 8" (2) total depth (feet) 100' (3) static water level (feet) 18 below top of ground. (4) casing P.V.C. 160 PSI (material) (depth) (size) If telescope see back. (5) screen 30' 70' (length) (depth to top) 8" PVC (size) (material) (6) pump 7 1/2 500 (HP) (yield gpm) Electric (type power) (7) electric log (yes or no) (organization running log) (8) how well bottom plugged CAPPED			
DRILLERS REMARKS:	Miss. Board of Water Comm. APR 16 1979 RECEIVED		

If well telescopes please sketch and show depths.

GROUND LEVEL

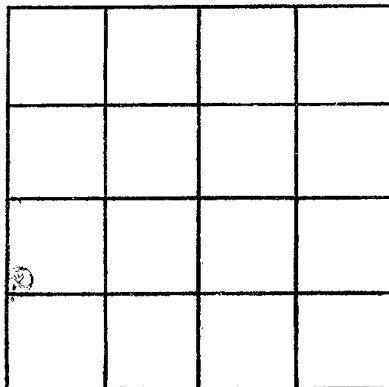

SECTION 32

Please indicate well location X.

ADDITIONAL INFORMATION

If more than one screen,
show locations of each on sketch.