

LeFlore  
K 31  
10-17-74

MISSISSIPPI  
BOARD OF WATER COMMISSIONERS  
416 North State Street  
Jackson, Mississippi 39201

CODING

WATER WELL DRILLERS LOG

10/17/74 date well completed  
 BUTANE GAS CO. OF GREENWOOD firm name  
 LeFlore county well located

LANDOWNER:	description of formations encountered	from	to
FORT LORING Plantation	Clay	0	12
Greenwood	Sand	12	35
(mailing address)	Sand + Gravel	35	125
WELL LOCATION:	Sand + Shale	125	312
sec. 13 T. 19 N R. 1 E	Shale	312	365
2 1/2 miles SW of Greenwood	Sandy Shale + Rock	365	583
(distance) (direction) (nearest town)	Sand + Shale streaks	583	779
WELL PURPOSE: Home	Hard Packed Sand	779	805
(home, irrigation, municipal, industrial)	Shale	805	822
WELL COMPLETION DATA:	Sand	822	939
(1) diameter (inches) 4 1/2	Shale	939	952
(2) total depth (feet) 923			
(3) static water level (feet) 4 below above top of ground.			
(4) casing Steel 883 (material) (depth)			
4 1/2 (size) If telescope see back.			
(5) screen 40' 883 (length) (depth to top)			
2" Stainless (size) (material)			
(6) pump 1 1/2 30 (HP) (yield gpm)			
Elec (type power)			
(7) electric log NO (yes or no)			
(organization running log)			
(8) how well bottom plugged BACK PRESSURE VALVE			
DRILLERS REMARKS:			

INDEXED  
 10/20/74  
 MISS. BD. OF WATER COMMISSIONERS


If well telescopes please sketch and show depths.

GROUND LEVEL

105' - 4" CASING →

778' - 2" CASING →

40' - 2" SCREEN →

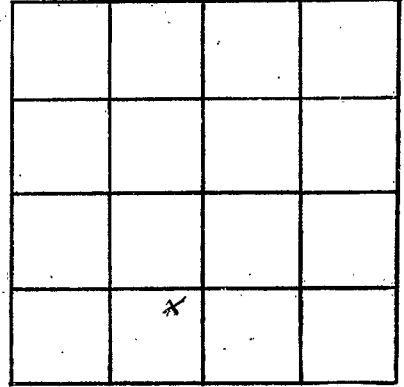

SECTION 13

Please indicate well location X.

ADDITIONAL INFORMATION

If more than one screen, show locations of each on sketch.