

Leflore

K 32

9-17-62

WATER WELL DRILLERS LOG

CODED

Date: SEPT 17, 1962, Driller: DELTA DRILLING Co County LEFLORE

(Name)

(1) Owner of Land: R. L. KELLY  
(Name)  
ETTA BENA, MISS.  
(Address)

(2) Location: NW 1/4, SW 1/4, Sec. 32 T20R1-W1  
\_\_\_\_\_ miles \_\_\_\_\_ of \_\_\_\_\_  
(distance) (direction) (Nearest Town)

(3) Topography: \_\_\_\_\_  
(Hilly) (Flat) (Level)

(4) Purpose of Well: DOMESTIC  
(Domestic Irrigation  
Municipal, Industrial, Other)

Description & Color of Materials Sand, Clay, Red Clay, Shell, etc.	Thick- ness Feet	Depth Feet
GUMBO -	34	34
SAND	60	94
GRAVEL	63	157
SAND	116	273
GUMBO	84	357
SHALE	94	451
SAND	117	568
SHALE <sup>CODED</sup> w/ 1/4" ROCK	58	626
SAND w/ 3/8" ROCK	44	670
SHALE	68	738
SAND	62	800
SHALE	50	850
SAND	26	876
SHALE	140	1016
SAND	28	1044
SHALE	28	1072
GUMBO	120	1192
SAND	38	1230

Information upon completion of well:

(1) Diameter 3 inches. **Yield 40 GPM**

(2) Total Depth 1230 feet. **+ 23'**


(3) Water Level WELL FLOWS feet below top of ground.

(4) Cased to 1230, Size 3 1/2"

(5) Screen: Size 2", Length 30

(6) Were any formations sealed against pollution?  
\_\_\_\_\_ yes, \_\_\_\_\_ no.

If YES depth of formation \_\_\_\_\_  
Why \_\_\_\_\_  
Drillers Remarks: 10 # Pressure  
40 G.P.M. FLOW -

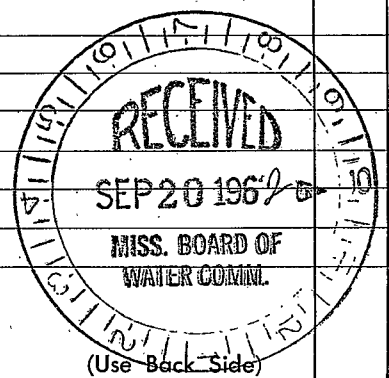

Well No.

