

K 33

7-24-63

WATER WELL DRILLERS LOG

CODED

Date: JULY 24, 1963, Driller: DELTA DRILLING Co. County LEFLORE
(Name)

(1) Owner of Land: WILLIAM HODGES-
(Name)
ITTA BENA, MISS-
(Address)

(2) Location: NW 1/4, SW 1/4, Sec. 17 T. 18N R. 1W
_____ miles _____ of _____
(distance) (direction) (Nearest Town)

(3) Topography: _____
(Hilly) (Flat) (Level)

(4) Purpose of Well: DOMESTIC
(Domestic Irrigation
Municipal, Industrial, Other)

Description & Color of Materials Sand, Clay, Red Clay, Shell, etc.	Thick- ness Feet	Depth Feet
SAND	67	67
GRAVEL	64	131
SAND	10	141
GUMBO	101	242
SHALE	30	276
SAND	156	432
GUMBO	54	486
SHALE	20	506
GUMBO	74	580
SHALE w/6" ROCK	75	655
GUMBO	20	675
SHALE w/10" ROCK-	50	725
SAND w/ROCKS	85	810
SHALE w/ROCKS-	35	845
SAND	26	871
SHALE w/5" ROCK-	22	893
GUMBO	69	962
SHALE	12	974
SAND	19	993
GUMBO	14	1007
SAND	20	1027
GUMBO	12	1039
SHALE	15	1054
SAND	48	1102

Information upon completion of well:

(1) Diameter 3 inches.

(2) Total Depth 1102 feet. *yield 609 gpm*

(3) Water Level Flows feet below top of ground.

(4) Cased to 1082, Size 4 9/8" - 2" *675' - 3"*

(5) Screen: Size 2", Length 20'


(6) Were any formations sealed against pollution?
_____ yes, _____ no.

If YES depth of formation _____

Why _____

Drillers Remarks: WELL FLOWS - APPROX

65 G.P.M. 25' LAP OF 2"
IN 3" PIPE

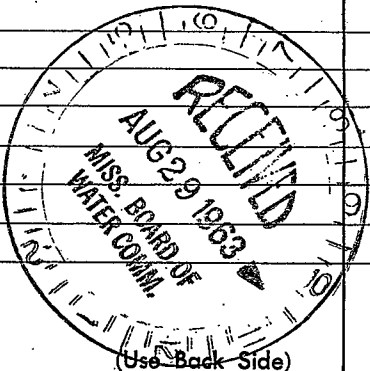

Well No. _____

10/11/11