

K 34

2-18-65

WATER WELL DRILLERS LOG

CODED

Date: Feb 18, 1965, Driller: DELTA DRILLING Co County LEFLORE

(Name)

(1) Owner of Land: J. A. BENNETT

(Name)

ITTA BENA, MISS.

(Address)

(2) Location: NE 1/4, SE 1/4, Sec. 34 T19R2W

_____ miles _____ of _____
(distance) (direction) (Nearest Town)

(3) Topography:

(Hilly) (Flat) (Level)

(4) Purpose of Well: DOMESTIC

(Domestic Irrigation
Municipal, Industrial, Other)

Information upon completion of well:

(1) Diameter 3 inches.

(2) Total Depth 1226 feet.

(3) Water Level FLOWS 44' feet below top of ground.

(4) Cased to 1161', Size 2" 513

(5) Screen: Size 2", Length 20'

(6) Were any formations sealed against pollution?

_____ yes, _____ no.

If YES depth of formation _____

Why _____


Drillers Remarks: 23' LAP OF 2" IN 3"

PIPE - FLOWS - 6:59 P.M. - 19#

PRESSURE - 22 L 2" TAIL

PIPE ON BOTTOM OF WELL

Description & Color of Materials Sand, Clay, Red Clay, Shell, etc.	Thick- ness Feet	Depth Feet
GUMBO	30	30
SAND	73	103
GRAVEL	40	143
GUMBO CODED	43	186
SAND	287	473
GUMBO	133	606
SHALE	31	637
GREEN SAND	168	805
SHALE	70	875
GREEN SAND	74	949
SHALE	29	978
GUMBO	12	990
SAND	20	1010
SHALE	60	1070
SAND	27	1097
SHALE	18	1115
GUMBO	33	1148
SHALE	4	1152
SAND	34	1186
SHALE	17	1203

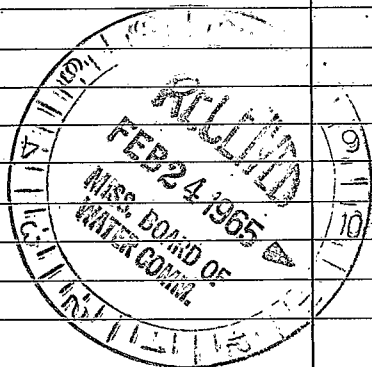

(Use Back Side)

Well No.

