

MISSISSIPPI
BOARD OF WATER COMMISSIONERS
416 North State Street
Jackson, Mississippi 39201

CODED

WATER WELL DRILLERS LOG

LeFlore
K35
3-67

3/29/67 19 Butawee Gas & Greenwood Le fore
date well completed firm name county well located

LANDOWNER: L.M. WADIE
LAKE HENRY PLANTATION
Box 288 - Greenwood, Miss.
(mailing address)

description of formations encountered from to

WELL LOCATION:
sec. 6 T 19 N R 1 E
3 miles NEW of TERRA BESSA
(distance) (direction) (nearest town)

Medium Grey Sand 370 450

WELL PURPOSE: Domestic
(home, irrigation, municipal, industrial)

WELL COMPLETION DATA:

(1) diameter (inches) 4" x 2"

(2) total depth (feet) 440'

(3) static water level (feet) 21 below top of ground.

(4) casing Galv., 420'
(material) (depth)

4" x 2" if telescope see back.
(size)

(5) screen 20', 420'
(length) (depth to top)

2", STAINLESS STEEL
(size) (material)

(6) pump 1 1/2, 5
(HP) (yield gpm)


Electric
(type power)

(7) electric log No
(yes or no)

(organization running log)


(8) how well bottom plugged Back Pressure Valve

CODED

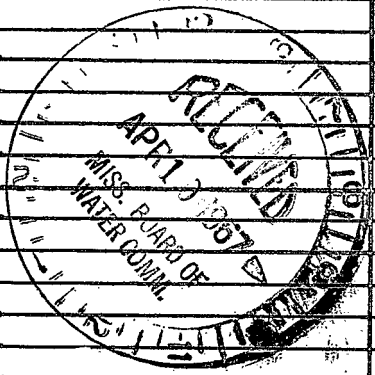

DRILLERS REMARKS:

If well telescopes please sketch and show depths.

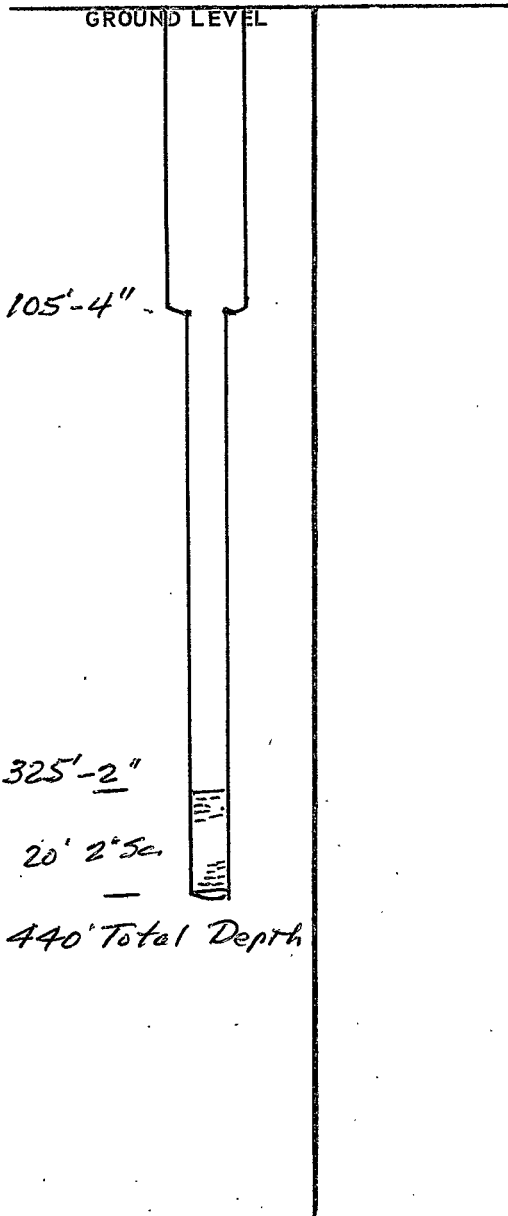

		X	

SECTION 6

Please indicate well location X.

ADDITIONAL INFORMATION

325'-2"

20' 2" 5c.

440' Total Depth

If more than one screen, show locations of each on sketch.