

**MISSISSIPPI
BOARD OF WATER COMMISSIONERS
416 North State Street
Jackson, Mississippi 39201**

WATER WELL DRILLERS LOG

CODED

LeFlore
K 36
4-67

19. Budawe Gas Co. of Greenwood LeFlore
date well completed firm name county well located

LANDOWNER: PAUL LAPE

Rt. 2 Box 540

Itta Bena, Miss.
(mailing address)

description of formations encountered

from

to

<u>Clay</u>	<u>0</u>	<u>30</u>
<u>SAND</u>	<u>30</u>	<u>63</u>
<u>SAND + GRAVEL</u>	<u>63</u>	<u>90</u>

WELL LOCATION:

sec. 24 T. 19 N. R. 1 E.
S W

5 miles SW of Greenwood
(distance) (direction) (nearest town)

WELL PURPOSE: Home
(home, irrigation, municipal, industrial)

WELL COMPLETION DATA:

(1) diameter (inches) 2"

(2) total depth (feet) 86'

(3) static water level (feet) 22 below above top of ground.

(4) casing Steel, 76
(material) (depth)

2"
(size) If telescope see back.

(5) screen 10, 76'
(length) (depth to top)

2, Stainless Steel
(size) (material)

(6) pump 1/2 5
(HP) (yield gpm)

Elec.
(type power)

(7) electric log NO
(yes or no)

(organization running log)

(8) how well bottom plugged Basic Pressure Valve


DRILLERS REMARKS:

CODED



If well telescopes please sketch and show depths.

GROUND LEVEL

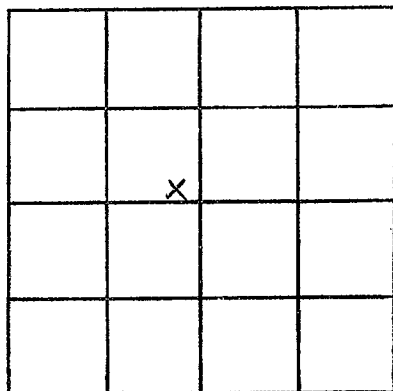

SECTION 24

Please indicate well location X.

ADDITIONAL INFORMATION

If more than one screen,
show locations of each on sketch.