

Leflore
K 38
1-68

MISSISSIPPI
BOARD OF WATER COMMISSIONERS
416 North State Street
Jackson, Mississippi 39201

CODED

WATER WELL DRILLERS LOG


JAN 15 '68 date well completed BOTANE of GREENWOOD LAFLORE firm name county well located

LANDOWNER:
FRANK COLEMAN
ITHA BEVA, MISS
(mailing address)
WELL LOCATION:
sec. 21 T. 19 N. R. 1 E
1/8 miles E of ITHA BEVA
(distance) (direction) (nearest town)

description of formations encountered	from	to
CLAY	1	15
SAND & GRAVEL	15	160
SANDY & SHALE	160	950
SHALE		
VERY SANDY SHALE	950	1060
GOOD SAND	1060	1112

WELL PURPOSE: HOME
(home, irrigation, municipal, industrial)

- WELL COMPLETION DATA:
- (1) diameter (inches) 4" X 2"
 - (2) total depth (feet) 1106'
 - (3) static water level (feet) 23 ^{below} top of ground. 120' GALV.
 - (4) casing 2 1/2" 985' GALV
(material) (depth)
4" X 2" if telescope see back.
(size)
 - (5) screen 20' 986'
(length) (depth to top)
2" 3.5. WIRE WRAPPED
(size) (material)
 - (6) pump 1 20-30
(HP) (yield gpm)
ELECTRIC
(type power)
 - (7) electric log No
(yes or no)
(organization running log)
 - (8) how well bottom plugged
BACK PRESSURE VALVE

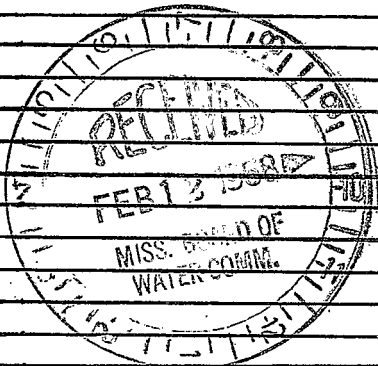

DRILLERS REMARKS:

If well telescopes please sketch and show depths.

GROUND LEVEL

4" GALV CAS.

120'
1"

SWAGE

965'
2" GALV.

986'

20' x 2'
3.5" SC.

1106' TD

BACK PRESSURE VALVE & GUIDE

X			

SECTION 21

Please indicate well location X.

ADDITIONAL INFORMATION

If more than one screen, show locations of each on sketch.