

LEFLORE  
 K39  
 11-24-75  
 Elog #95

MISSISSIPPI  
 BOARD OF WATER COMMISSIONERS  
 416 North State Street  
 Jackson, Mississippi 39201

WATER WELL DRILLERS LOG

Nov. 24, 1975, Robert E. Rathiff Leflore Co.

date well completed Flowood plantation firm name county well located

LANDOWNER: Mississippi State Park Commission  
 (mailing address)

description of formations encountered	from	to
Top Soil	0	10
Top SAND	10	90
GRAVEL	90	130
CLAY	130	160
SAND	160	208
Blue CLAY	200	220
SAND	220	280
CLAY	280	370
SANDY shale	370	408
SAND	400	440
SAND & shale	440	530
shale	520	570
SAND	570	620
SAND & shale	620	720
SAND	720	750
SAND & shale	750	840
Good SAND	840	930

WELL LOCATION:  
 sec. 12 T19 N 1 R 1 E  
2 miles W of GREENWOOD  
 (distance) (direction) (nearest town)

WELL PURPOSE: PLANTATION  
 (home, irrigation, municipal, industrial)

- WELL COMPLETION DATA:
- diameter (inches) 12"
  - total depth (feet) 930'
  - static water level (feet) 5' below above top of ground.
  - casing steel 840'  
 (material) (depth)  
12 X 4 if telescope see back.  
 (size)
  - screen 60  
 (length) (depth to top)  
4 STAINLESS Steel  
 (size) (material)
  - pump 20 200  
 (HP) (yield gpm)  
Electric  
 (type power)
  - electric log yes  
 (yes or no)  
U.S. & Miss.  
 (organization running log)
  - how well bottom plugged BPU

DRILLERS REMARKS:

REG. 1 11/25  
 COMM


If well telescopes please sketch and show depths.

GROUND LEVEL

809' Top of Lap

980'

60' SCREEN

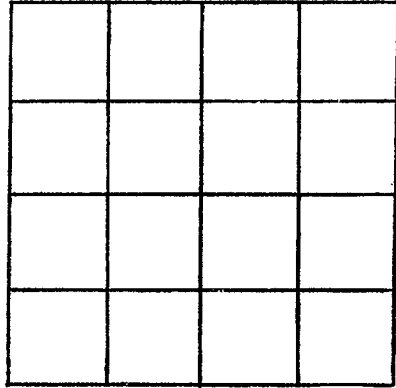

SECTION \_\_\_\_\_

Please indicate well location X.

ADDITIONAL INFORMATION

If more than one screen, show locations of each on sketch.