

LEFLORE
K 41
2-27-75

MISSISSIPPI
BOARD OF WATER COMMISSIONERS
416 North State Street
Jackson, Mississippi 39201

WATER WELL DRILLERS LOG

CODED

Feb. 27, 1975 DIER-Sullivan Leflore
date well completed firm name county well located

LANDOWNER: Jimmy P. Hill

description of formations encountered from to

Greenwood, Miss.
(mailing address)

<u>Clay</u>	0	27
<u>FINE SAND</u>	27	74
<u>SAND & GRAVEL</u>	74	114

WELL LOCATION:

sec 2 T 190 N R 1 E
S W
3 miles NW of Greenwood
(distance) (direction) (nearest town)

CODED

WELL PURPOSE: Domestic
(home, irrigation, municipal, industrial)

WELL COMPLETION DATA:

- (1) diameter (inches) 16"
- (2) total depth (feet) 114'
- (3) static water level (feet) 12 below above top of ground.
- (4) casing Blk Iron, 74'
(material) (depth)
16 if telescope see back.
(size)
- (5) screen 40', 74'
(length) (depth to top)
16", Blk Ingot
(size) (material)
- (6) pump 40 2000
(HP) (yield gpm)
Electric
(type power)
- (7) electric log No
(yes or no)

(organization running log)


(8) how well bottom plugged Plate

REGISTERED
OCT 18 1975

DRILLERS REMARKS:

If well telescopes please sketch and show depths.

GROUND LEVEL

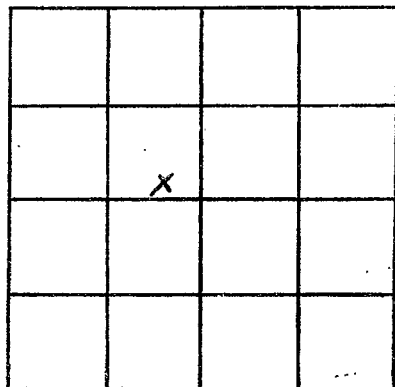

SECTION 2

Please indicate well location X.

ADDITIONAL INFORMATION

If more than one screen, show locations of each on sketch.