

GW 13787

LEFLORE

K47

9-76

Elog #97

MISSISSIPPI BOARD OF WATER COMMISSIONERS 416 North State Street Jackson, Mississippi 39201

CODED

WATER WELL DRILLERS LOG

Sept. 1976 date well completed

Herndon Well & Supply, Inc. firm name

LeFlore county well located

LANDOWNER: City of Itta Bena	description of formations encountered	from	to
Bena	Clay	0	15
Itta Bena, MS	Sand	15	30
(mailing address)	Streaked Sand	30	90
	Pea Gravel	90	110
WELL LOCATION:	Sand	110	120
sec. 20 T. 21 N R. 1 E	Streaked Gumbo & Sand	120	145
X S W	Gravel	145	150
inside Itta Bena	Sand	150	180
(distance) miles (direction) of (nearest town)	Gumbo	180	200
WELL PURPOSE: Municipal	Sand	200	330
(home, irrigation, municipal, industrial)	330 Gumbo	330	390
WELL COMPLETION DATA:	Sand	390	480
(1) diameter (inches) 12 x 8	Gumbo	480	570
(2) total depth (feet) 1110	Sand	570	598
(3) static water level (feet) 4 above top of ground.	Rock	598	599
(4) casing Steel 1020	Gumbo	599	660
(material) (depth)	Strk Gumbo & Sand	660	700
12 If telescope see back.	Rock	700	706
(size)	Gumbo / Sand Strks	706	780
(5) screen 80	Gumbo	780	990
(length) (depth to top)	Gumbo and Sand	990	1020
8" 1030 Stainless St.	Sand & 3' Strk of Gumbo	1020	1050
(size) (material)	Sand	1050	1100
(6) pump 40 500	Strkd Sand & Gumbo	1100	1140
(HP) (yield gpm)	Gumbo	1140	1200
Elec.			
(type power)			
(7) electric log yes			
(yes or no)			
Ms State Geological Sur.			
(organization running log)			
(8) how well bottom plugged 8" BWV			

CODED

RECEIVED SEP 27 1976


MISS. BD OF WATER COMM

DRILLERS REMARKS:


If well telescopes please sketch and show depths.

WB #4

GROUND LEVEL

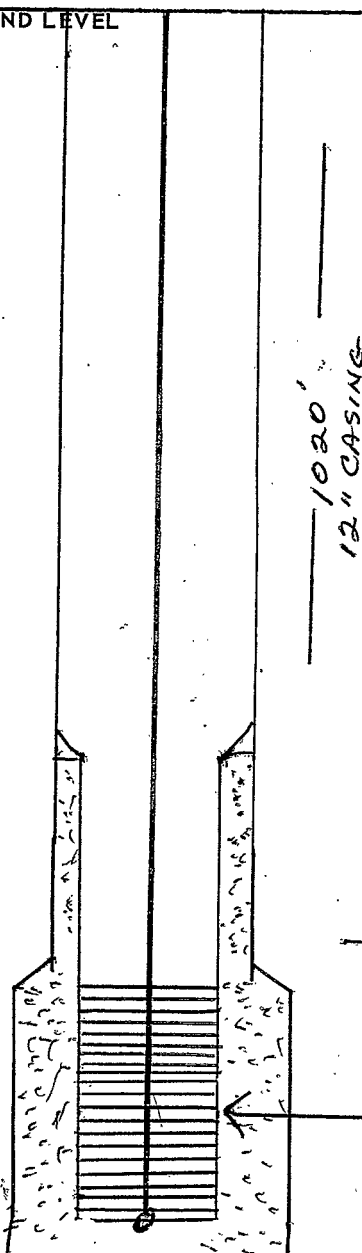

1020'
12" CASING

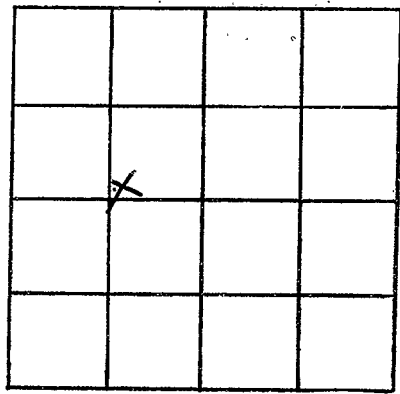

SECTION 20

Please indicate well location X.

ADDITIONAL INFORMATION

WB #4
500 GPM : 25 GPF

TOP OF LAP 948'

60' AIR LINE 1/4" COPPER

678" LAP 8"

80' .030 S.S.

UNDERGEAMED HOLE 32"

8" CT BLV

T.D 1100'

If more than one screen, show locations of each on sketch.