

LeFlore
K 52
11-20-79

MISSISSIPPI
 BOARD OF WATER COMMISSIONERS
 416 North State Street
 Jackson, Mississippi 39201

CODED

WATER WELL DRILLERS LOG
 BUTANE GAS COMPANY
 OF GREENWOOD

11-20-79 19
 date well completed

LeFlore
 county well located

LANDOWNER:
DR. JACK CROWELL
Ruleville
 (mailing address)

description of formations encountered	from	to
<u>Clay</u>	<u>1</u>	<u>45</u>
<u>Sand</u>	<u>45</u>	<u>55</u>
<u>Sand & Gravel</u>	<u>55</u>	<u>105</u>

WELL LOCATION:
 sec 24 T 19 N R 1 E
1/2 miles NW of Itta Bena
 (distance) (direction) (nearest town)

CODED

WELL PURPOSE: FR
 (home, irrigation, municipal, industrial)

- WELL COMPLETION DATA:
- (1) diameter (inches) 16"
 - (2) total depth (feet) 105
 - (3) static water level (feet) 20 below above top of ground.
 - (4) casing Steel ; 65 ;
 (material) (depth)
16" if telescope see back.
 (size)
 - (5) screen 40 , 65
 (length) (depth to top)
16" , Steel
 (size) (material)
 - (6) pump 60 2500
 (HP) (yield gpm)
Diesel
 (type power)
 - (7) electric log No
 (yes or no)
 (organization running log)
 - (8) how well bottom plugged:
Steel Plate

DEPT. OF NATURAL RESOURCES
 BUREAU OF LAND & WATER RESOURCES


NOV 28 1979

RECEIVED

DRILLERS REMARKS:

If well telescopes please sketch and show depths.

GROUND LEVEL

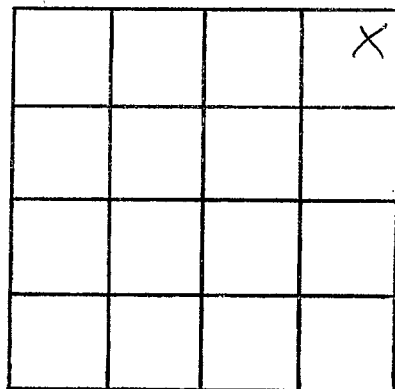

SECTION 2f

Please indicate well location X.

ADDITIONAL INFORMATION

If more than one screen,
show locations of each on sketch.