

LeFlore  
K53  
10-23-80

MISSISSIPPI  
BOARD OF WATER COMMISSIONERS  
416 North State Street  
Jackson, Mississippi 39201

CODED

WATER WELL DRILLERS LOG

OCT 23 1980 BUTANE GAS COMPANY  
OF GREENWOOD

LEFLORE  
county well located


LANDOWNER	description of formations encountered	from	to
McLEAN Gin Co ITHA BENA, MS	CLAY	1	18
	SAND	18	60
	SAND & GRAVEL	60	98
(mailing address)			
WELL LOCATION: sec. 32 190 N R 1 E S W 2 miles South of ITHA BENA (distance) (direction) (nearest town)			
WELL PURPOSE: INDUSTRIAL (home, irrigation, municipal, industrial)			
WELL COMPLETION DATA:			
(1) diameter (inches) 4"			
(2) total depth (feet) 98			
(3) static water level (feet) 22' below top of ground.			
(4) casing PVC 78' (material) (depth)			
(size) if telescope see back.			
(5) screen 20' 78' (length) (depth to top)			
4" PVC (size) (material)			
(6) pump 1 20 (HP) (yield gpm)			
Electric (type power)			
(7) electric log No (yes or no)			
No (organization running log)			
(8) how well bottom plugged Back Pressure Valve			
DRILLERS REMARKS:			

DEPT. OF NATURAL RESOURCES  
BUREAU OF LAND & WATER RESOURCES  
OCT 31 1980

RECEIVED

If well telescopes please sketch and show depths.

GROUND LEVEL

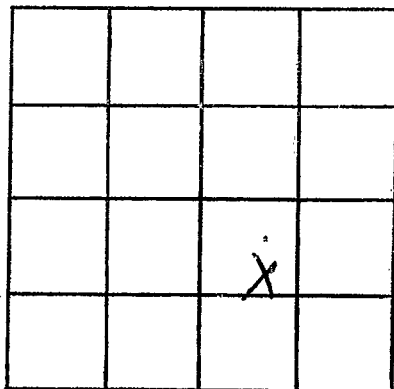

SECTION 32

Please indicate well location X.

ADDITIONAL INFORMATION

If more than one screen,  
show locations of each on sketch.