

Bureau of Land and Water Resources
 Southport Mall
 P.O. Box 10631

CODED

Jackson, Mississippi 39209
 WATER WELL DRILLERS LOG

Leflore
4K 54
3-3-81

3/3 19 *81* *Dye* *Leflore*
 date well completed firm name county well located


LANDOWNER:
LEFLORE COUNTY
COUNTRY CLUB
Crownwood (mailing address) *MS*
 WELL LOCATION:
 sec. *10* T. *190* N. R. *1* E. S. *5*
5 miles *W* of *Forestwood*
 (distance) (direction) (nearest town)

description of formations encountered	from to	
	ft	ft
<i>Clay</i>	<i>0</i>	<i>24</i>
<i>fine sand</i>	<i>24</i>	<i>38</i>
<i>sand</i>	<i>38</i>	<i>48</i>
<i>Sandy Gravel + Clay</i>	<i>48</i>	<i>58</i>
<i>Sand & Gravel</i>	<i>58</i>	<i>88</i>


WELL PURPOSE:
 (home, irrigation, municipal, industrial)

WELL COMPLETION DATA:
 (1) diameter (inches) *12"*
 (2) total depth (feet) *88'*
 (3) static water level (feet) *20'* below above top of ground.
 (4) casing *steel* *88'*
 (material) (depth)
12" If telescope see back.
 (size)
 (5) screen *40'* *44'*
 (length) (depth to top)
12" *steel*
 (size) (material)
 (6) pump *40* *2000*
 (HP) (yield gpm)
electric
 (type power)
 (7) electric log (yes or no)
 (organization running log)
 (8) how well bottom plugged *plate*

CODED

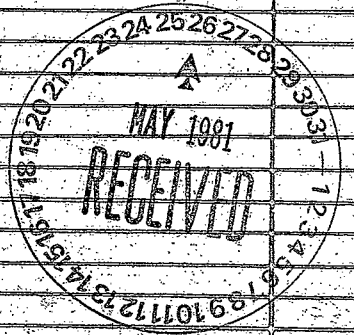

DRILLERS REMARKS:

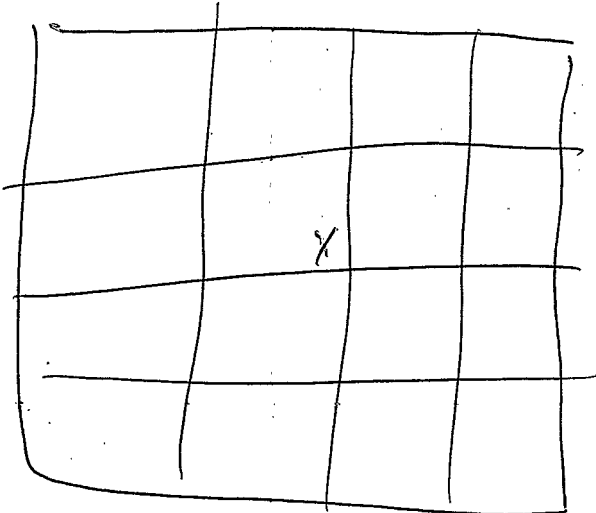

See 10