

MISSISSIPPI DEPARTMENT OF NATURAL RESOURCES
Bureau of Land and Water Resources

Southport Mall
P.O. Box 10631

Jackson, Mississippi 39209

CODED

WATER WELL DRILLERS LOG
BUTANE GAS COMPANY

K55
Leflore Co.
4-18-84

4-18 1984
date well completed

OF GREENWOOD
firm name

Leflore
county well located

LANDOWNER:
George Saunders
Ottobena
(mailing address)

description of formations encountered	from	to
<u>Clay</u>	<u>0</u>	<u>10</u>
<u>Loose sand</u>	<u>10</u>	<u>78</u>
<u>sand & gravel</u>	<u>78</u>	<u>110</u>

WELL LOCATION:
sec. 21 T. 13 N. R. 1 E.
1 miles E of Ottobena
(distance) (direction) (nearest town)

CODED

WELL PURPOSE: Irrigation
(home, irrigation, municipal, industrial)

- WELL COMPLETION DATA:
- (1) diameter (inches) 12"
 - (2) total depth (feet) 110'
 - (3) static water level (feet) 26' ^{below} _{above} top of ground.
 - (4) casing Steel 70'
(material) (depth)
12" if telescope see back.
(size)
 - (5) screen 40' 70'
(length) (depth to top)
12", Steel
(size) (material)
 - (6) pump 60 1100
(HP) (yield gpm)
Direct
(type power)
 - (7) electric log NO
(yes or no)
NO
(organization running log)
 - (8) how well bottom plugged Steel plate

DRILLERS REMARKS:
Richard West Dr


DEPT. OF NATURAL RESOURCES
BUREAU OF LAND & WATER RESOURCES

APR 23 1984

RECEIVED

If well telescopes please sketch and show depths.

GROUND LEVEL

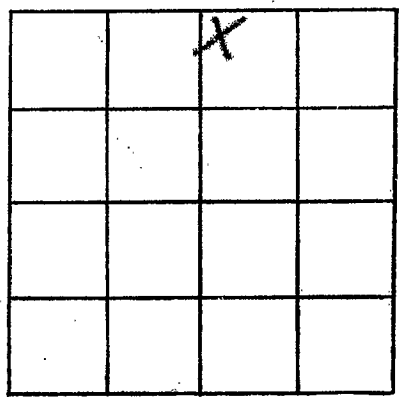

SECTION 21

Please indicate well location X.

ADDITIONAL INFORMATION

Lined area for additional information.

If more than one screen, show locations of each on sketch.