

MISSISSIPPI DEPARTMENT OF NATURAL RESOURCES
 Bureau of Land and Water Resources
 Southport Mall
 P.O. Box 10631
 Jackson, Mississippi 39209
WATER WELL DRILLERS LOG

CODED

Lefflore
R 56
8/13/81

Aug. 13 1981 Dyer Well + Irrigation Lefflore
 date well completed firm name county well located

LANDOWNER: Triple S Farms
Itta Bena, MS
 (mailing address)

description of formations encountered	from	to
Clay	0	28
Fine Sand	28	34
Sand	34	44
Sand + Gravel	44	98

WELL LOCATION:
 sec. 9 T 19 (N) R. 2 (E)
 S W
4 miles North of Itta Bena
 (distance) (direction) (nearest town)

WELL PURPOSE:
 (home, irrigation, municipal, industrial)

WELL COMPLETION DATA:

- (1) diameter (inches) 16"
- (2) total depth (feet) 98
- (3) static water level (feet) 22 below above top of ground.
- (4) casing Steel, 58,
 (material) (depth)
- 16 If telescope see back.
 (size)
- (5) screen 40", 58
 (length) (depth to top)
- 16", Steel
 (size) (material)
- (6) pump 60 3000
 (HP) (yield gpm)
- Diesel
 (type power)
- (7) electric log No
 (yes or no)
- None
 (organization running log)
- (8) how well bottom plugged Plugged

DRILLERS REMARKS:

DEPT. OF NATURAL RESOURCES
 BUREAU OF LAND AND WATER RESOURCES
CODED


AUG 26 1981

RECEIVED

MISSISSIPPI DEPARTMENT OF NATURAL RESOURCES
 BUREAU OF LAND AND WATER RESOURCES
RECEIVED
 AUG 26 1981

If well telescopes please sketch and show depths.

GROUND LEVEL

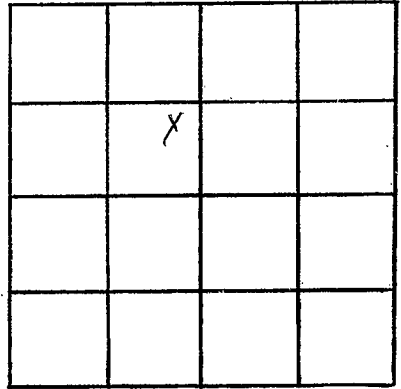

SECTION 9

Please indicate well location X.

ADDITIONAL INFORMATION

If more than one screen,
show locations of each on sketch.