

MISSISSIPPI DEPARTMENT OF NATURAL RESOURCES

Bureau of Land and Water Resources

Southport Mall

P.O. Box 10631

Jackson, Mississippi 39209

WATER WELL DRILLERS LOG

Permit Applied For K 58

5-7 1988 Dyer Well Leflore
 date well completed firm name county well located

LANDOWNER: Joe George Sanders

Description of formations encountered

from to

Rt 1 Box 108A
 Itha Bina Ms
 (mailing address)

Clay	0	28
Sand + Clay	28	38
Sand + Gravel	38	45
M Sand + Gravel	45	55
Fine Sand	55	78
Sand + Gravel	78	104

WELL LOCATION:

sec. 21 T 19 N R 1 E
 1 miles E of Itha Bina
 (distance) (direction) (nearest town)

WELL PURPOSE: Irrigation
 (home, irrigation, municipal, industrial)

WELL COMPLETION DATA:

- (1) diameter (inches) 12"
- (2) total depth (feet) 104'
- (3) static water level (feet) _____ below above top of ground.
- (4) casing Steel (material), (depth) 12" if telescope see back. (size)
- (5) screen 40' (length), (depth to top) 12" (size), (material)
- (6) pump 60 (HP), (yield gpm) Gear (type power)
- (7) electric log No (yes or no) None (organization running log)
- (8) how well bottom plugged Plate

RECEIVED


JUN 06 1988

Department of Natural Resources
 Bureau of Land and Water Resources

DRILLERS REMARKS:

If well telescopes please sketch and show depths.

GROUND LEVEL

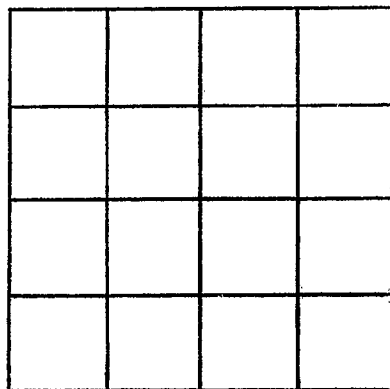

SECTION _____

Please indicate well location X.

ADDITIONAL INFORMATION

If more than one screen, show locations of each on sketch.